


T. 8 S., R. 3 W. W.M.

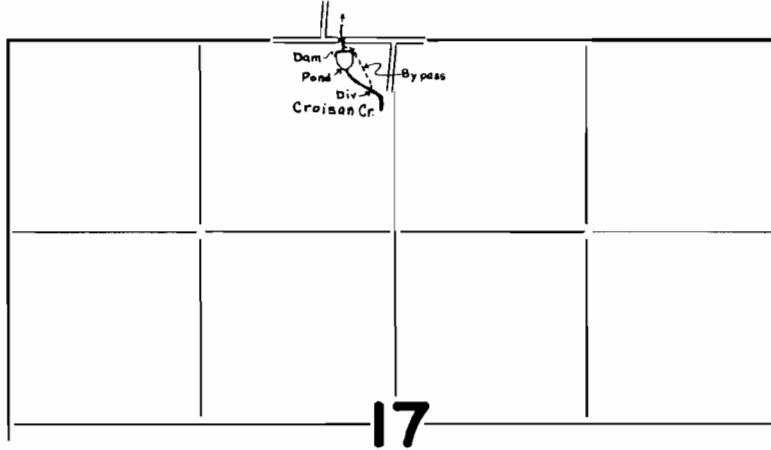

**FINAL PROOF SURVEY**  
UNDER

Application No. 18897 Permit No. 14512

IN NAME OF

Oscar Meyer

Surveyed July 13 1942, by Geo. V. Anderson