


T. 3 S., R. 1 W. W.M.

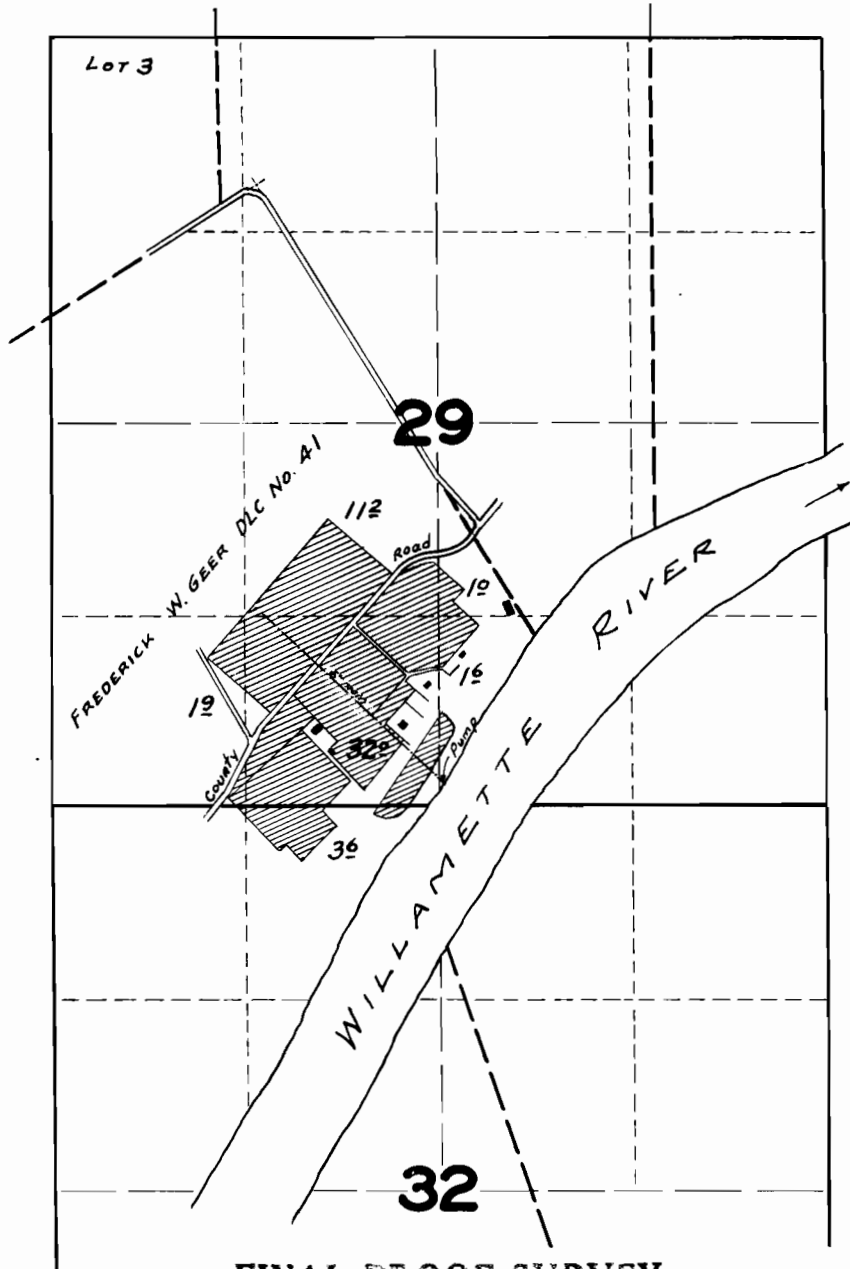

FINAL PROOF SURVEY UNDER

Application No. 19099 Permit No. 14706

IN FAVOR OF

Grace N. Williams

Surveyed Aug. 1, 1942, by Carl Madernon