


T. 6 S., R. 1 W. W.M.

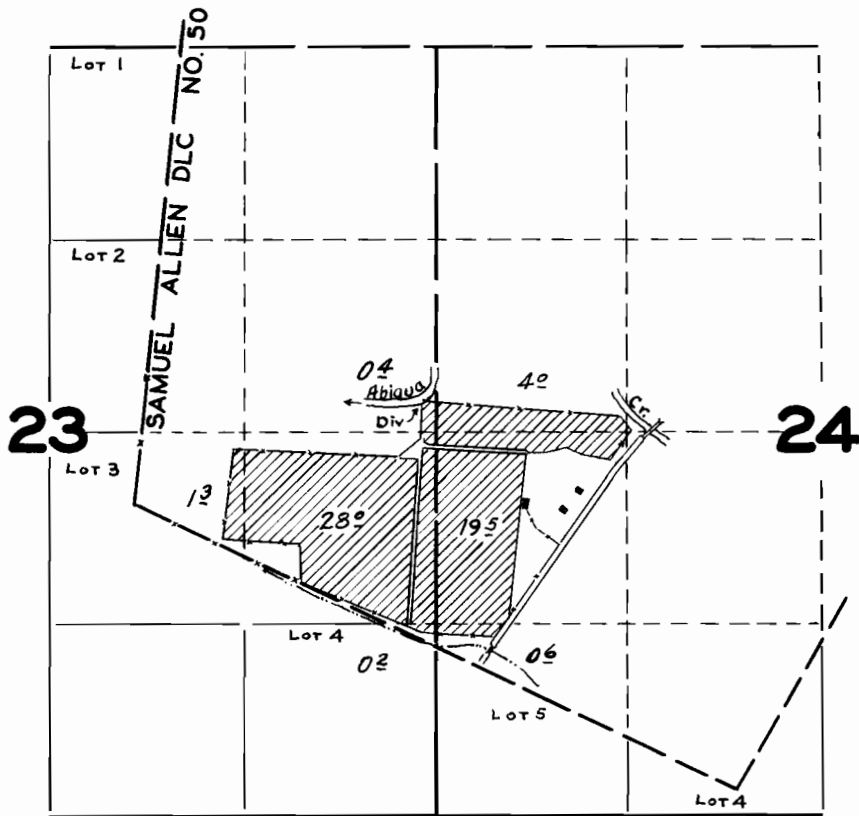

FINAL PROOF SURVEY UNDER

Application No. 19113 Permit No. 14718

IN NAME OF

Williams & Hart

Surveyed July 7, 1947, by Geo. Maderman