


T. 3 S., R. 1 W. W.M.

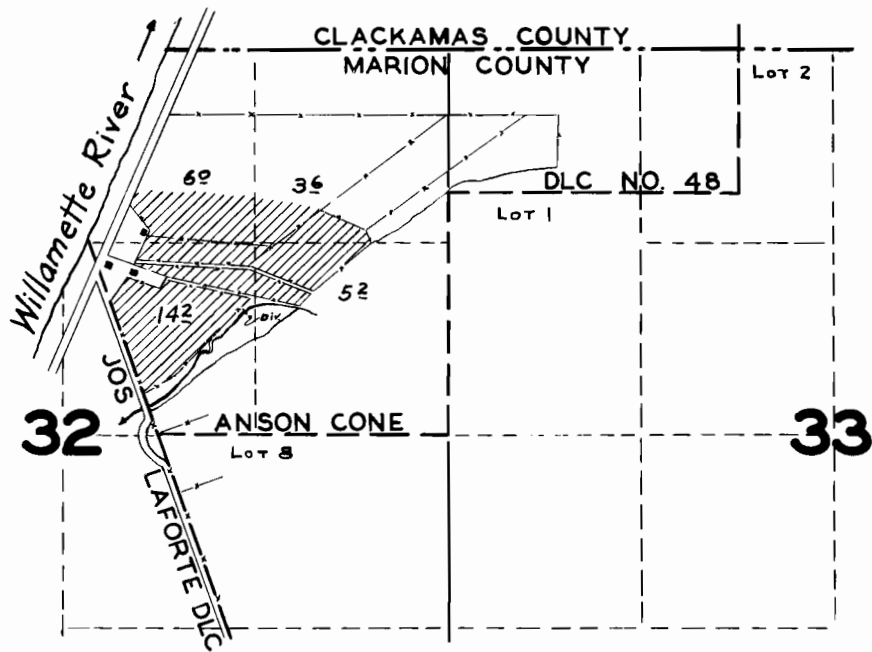

FINAL PROOF SURVEY UNDER

Application No. 19164 Permit No. 14762

IN NAME OF

Bertha Scholz

Surveyed June 24 1942, by Geol. Maderman