


T. 1 S., R. 1 W. W.M.

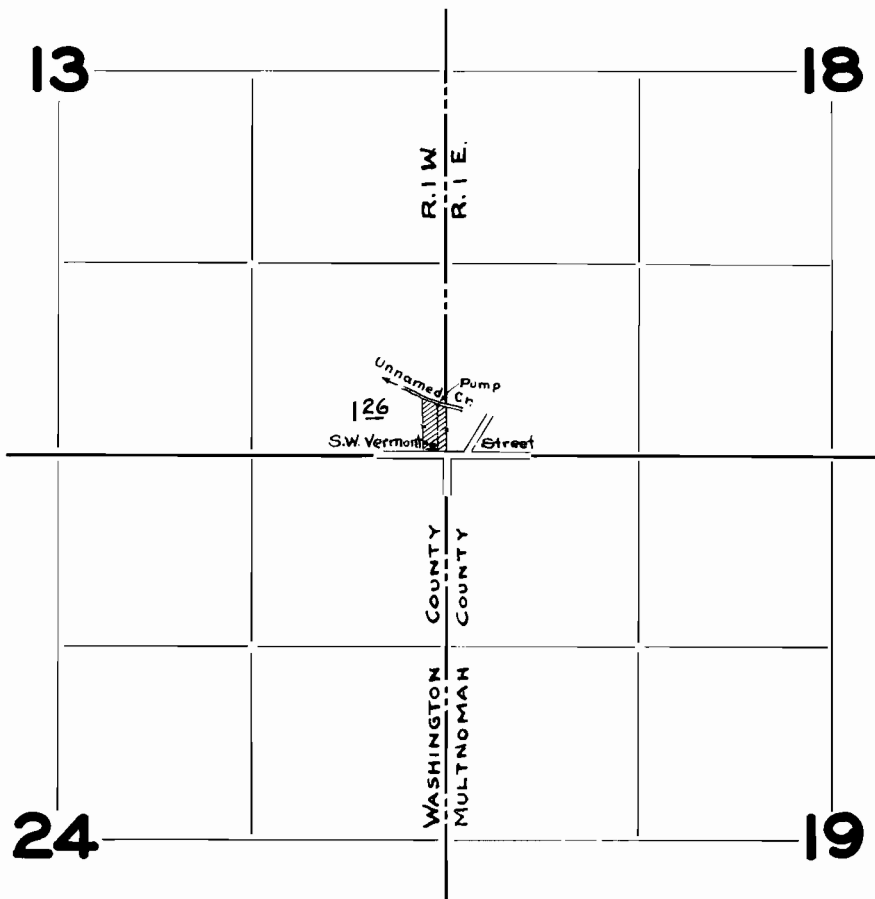

FINAL PROOF SURVEY UNDER

Application No. 19171 Permit No. 14768

IN FAVOR OF

A.L. & Helen M. Oleson

Surveyed Aug 3, 1942 by Geoff Maderman