


T. 2 S., R. 1 E. W.M.

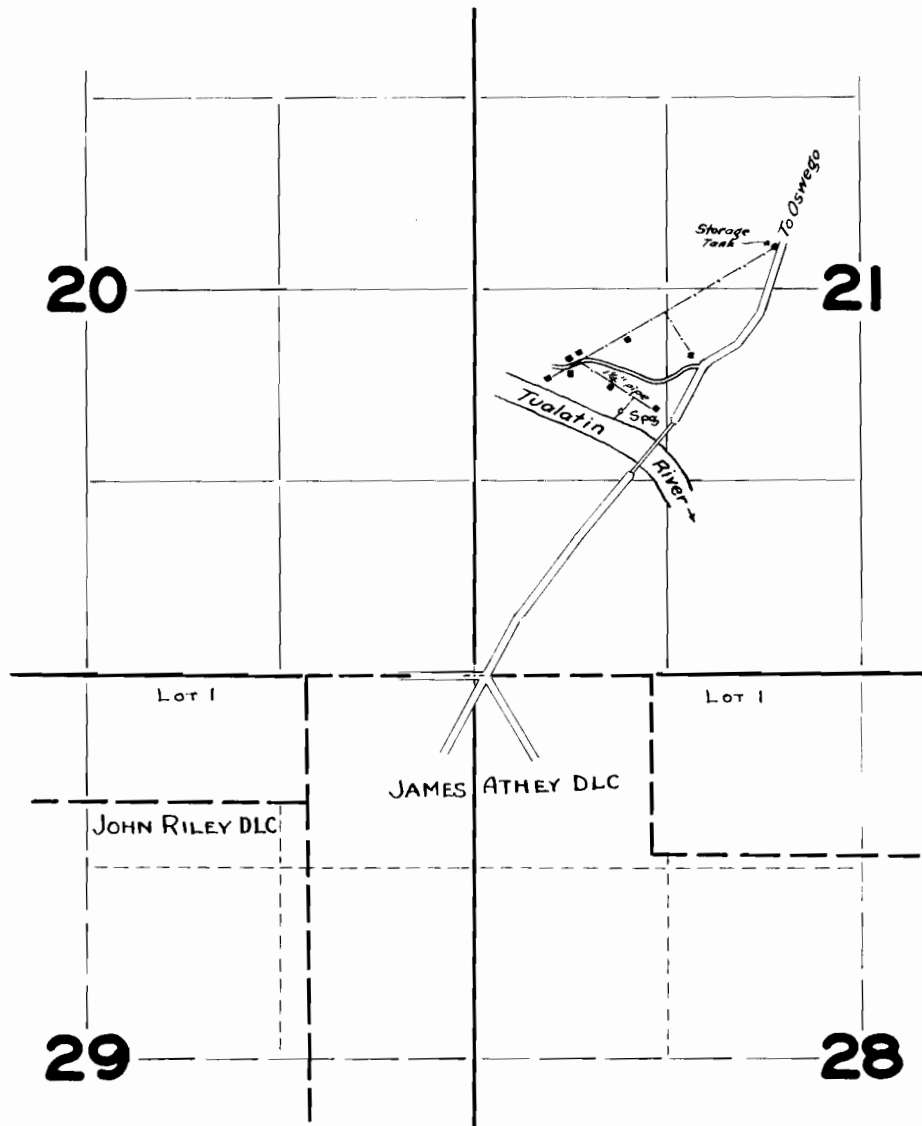

FINAL PROOF SURVEY

UNDER

Application No. 19182      Case No. 14779

A.S. Pattullo Estate

Surveyed July 31 1942, by *Geoff. Naderman*