


T. 7 S..R. I W. W.M.

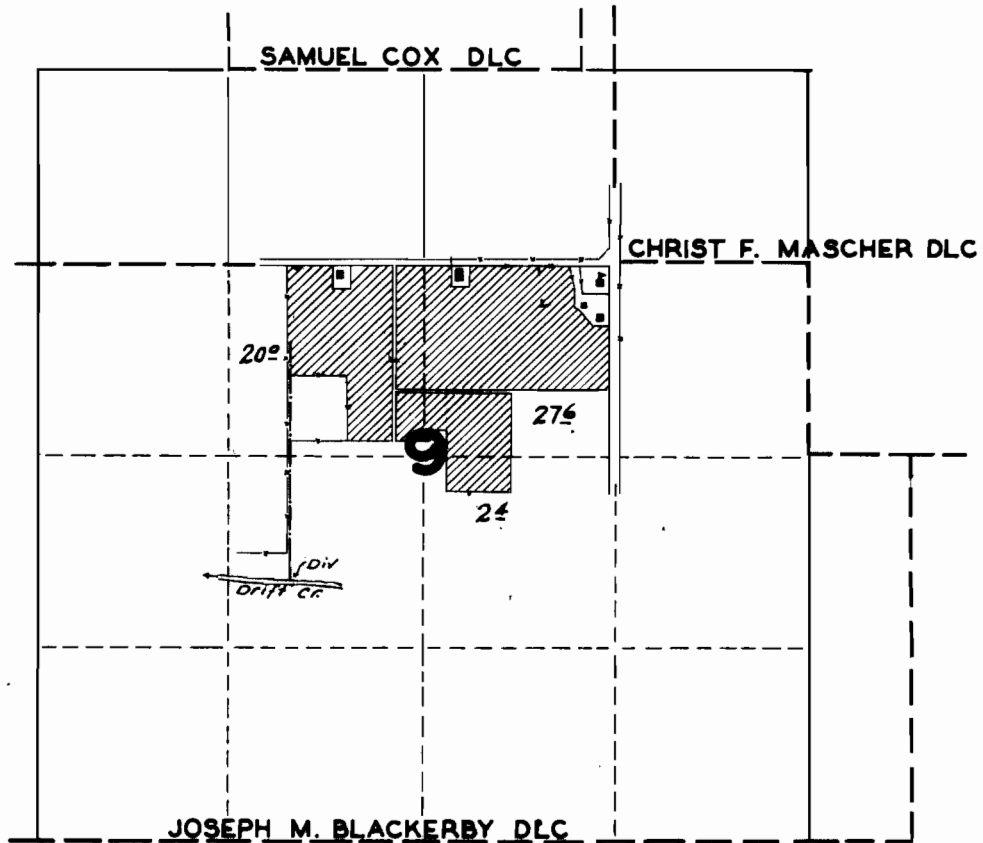

FINAL PROOF SURVEY

UNDER

Application No. 19193 Permit No. 14789

IN NAME OF

F. D. Kaser

Surveyed June 27, 1942, by Geoff Naderman