


T. I S., R. I E. W.M.

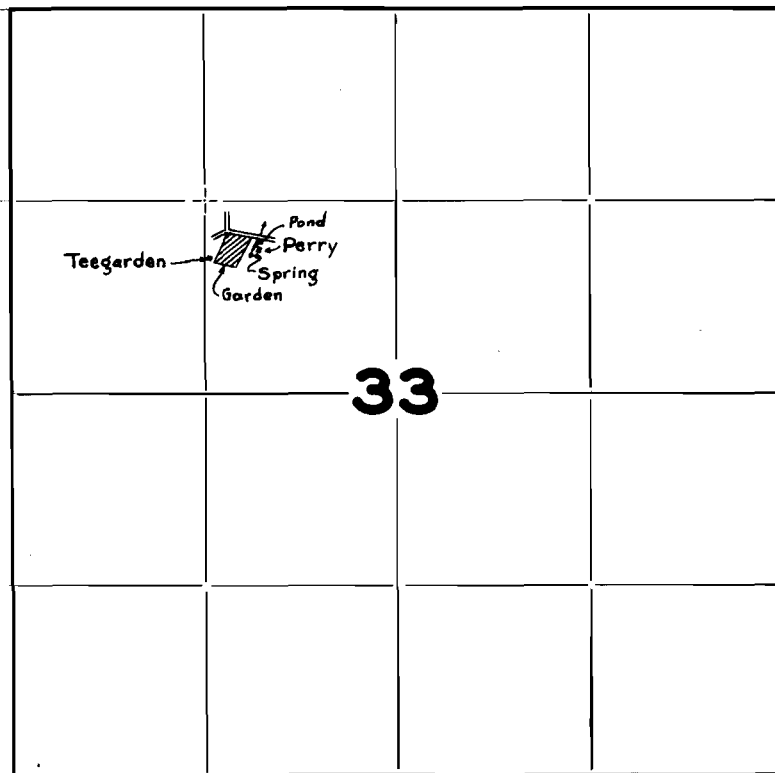

FINAL PROOF SURVEY UNDER

Application No. 19293 Permit No. 14881

IN FAVOR OF

F. Teegarden & Will Perry

Surveyed July 30 1942, by Geo. D. Anderson