


T. 7 S., R. 11 W. W.M.

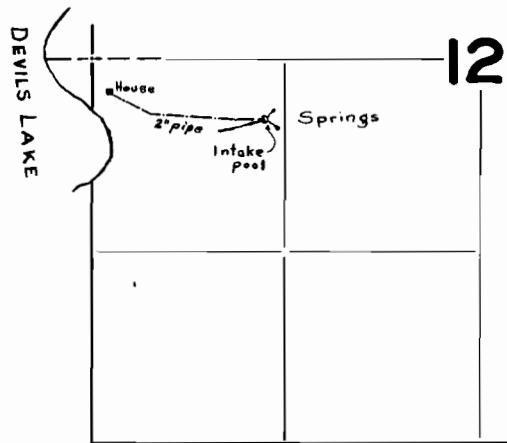

**FINAL PROOF SURVEY**  
UNDER

Application No. 19344 Permit No. 14931

IN NAME OF

August Johnson

Surveyed Sept. 8, 1942, by Geo. W. Naderman