


T. 5 S., R. 2 E. W.M.

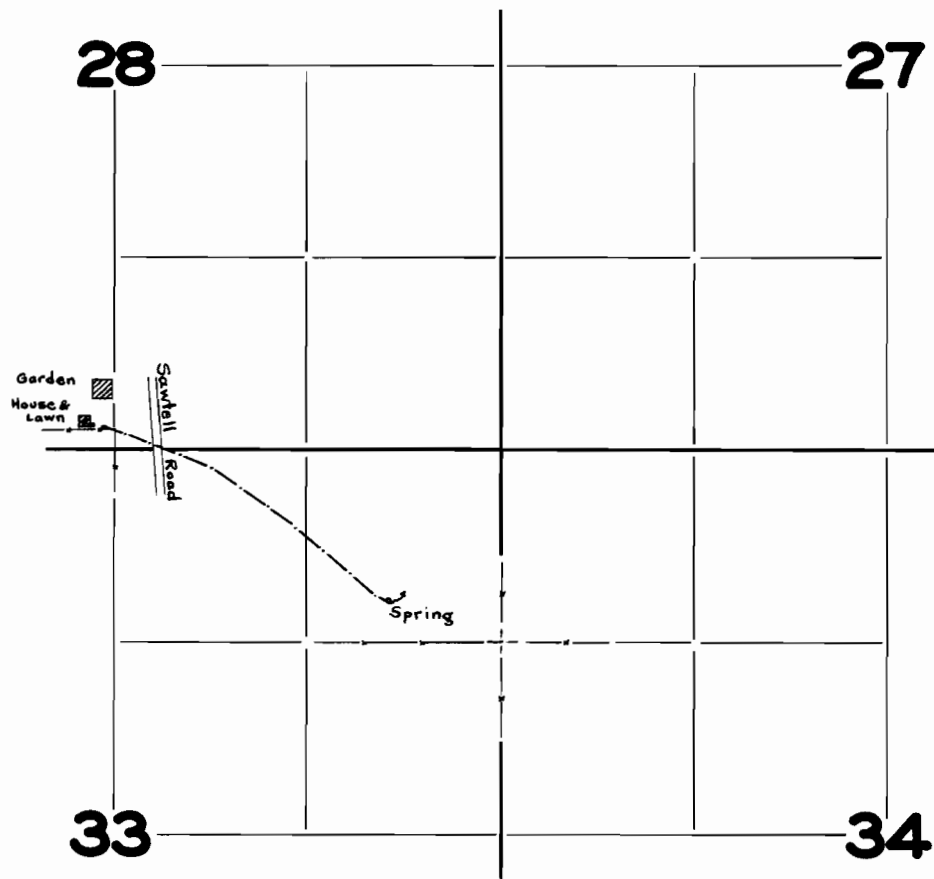

FINAL PROOF SURVEY
UNDER

Application No. 19353 Permit No. 14937

IN FAVOR OF

Philip Steiner

Surveyed July 23 1942, by Earl Maderman