


T. 4 S., R. 1 E. W.M.

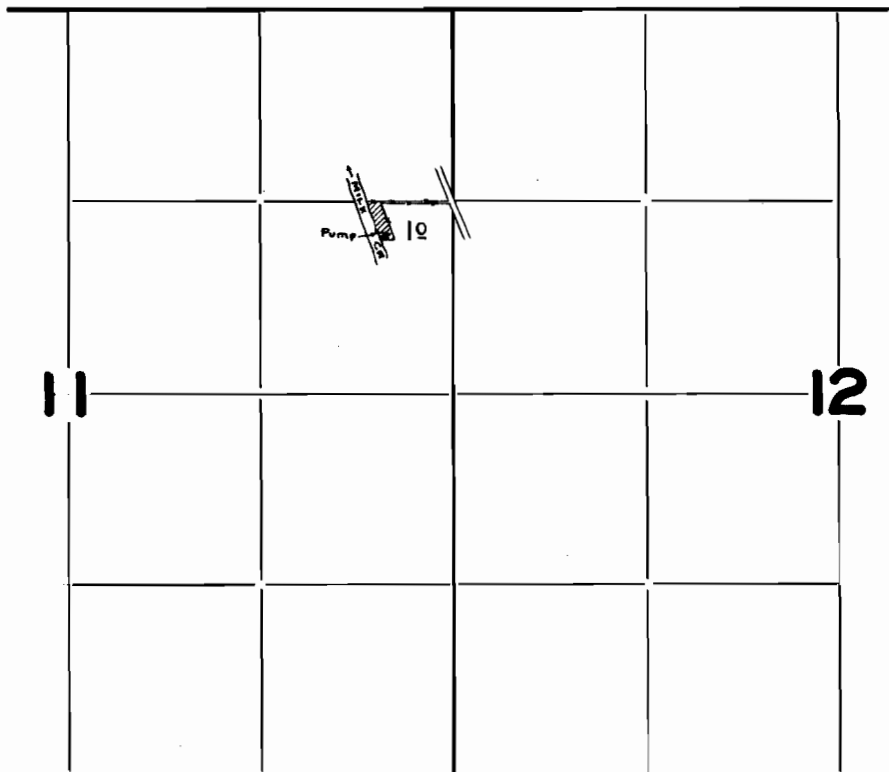

**FINAL PROOF SURVEY
UNDER**

Application No. 19399 Permit No. 14980

IN NAME OF

Elsie F. Darnell

Surveyed July 22 1942, by Geo. W. Pademan