


T. 9 S., R. 3 W. W.M.

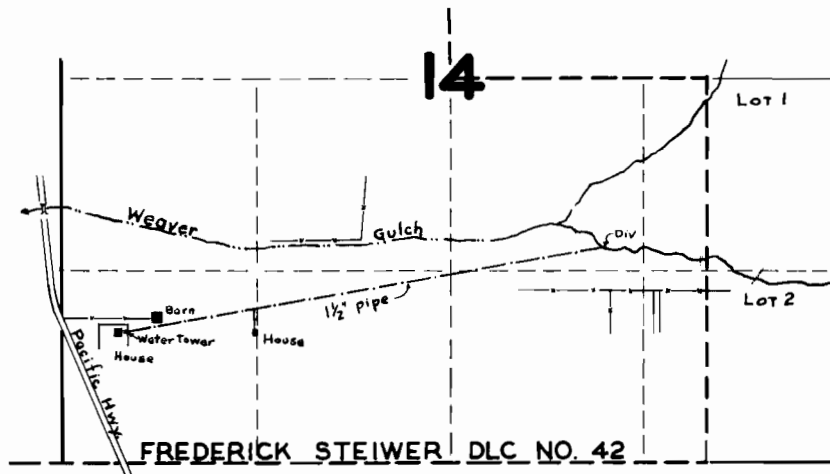

FINAL PROOF SURVEY

UNDER

Application No. 19385 Permit No. 14992

IN NAME OF

Karl Steiwer

Surveyed July 14 1942, by Geod Mademan