


T. I S., R. I W. W.M.

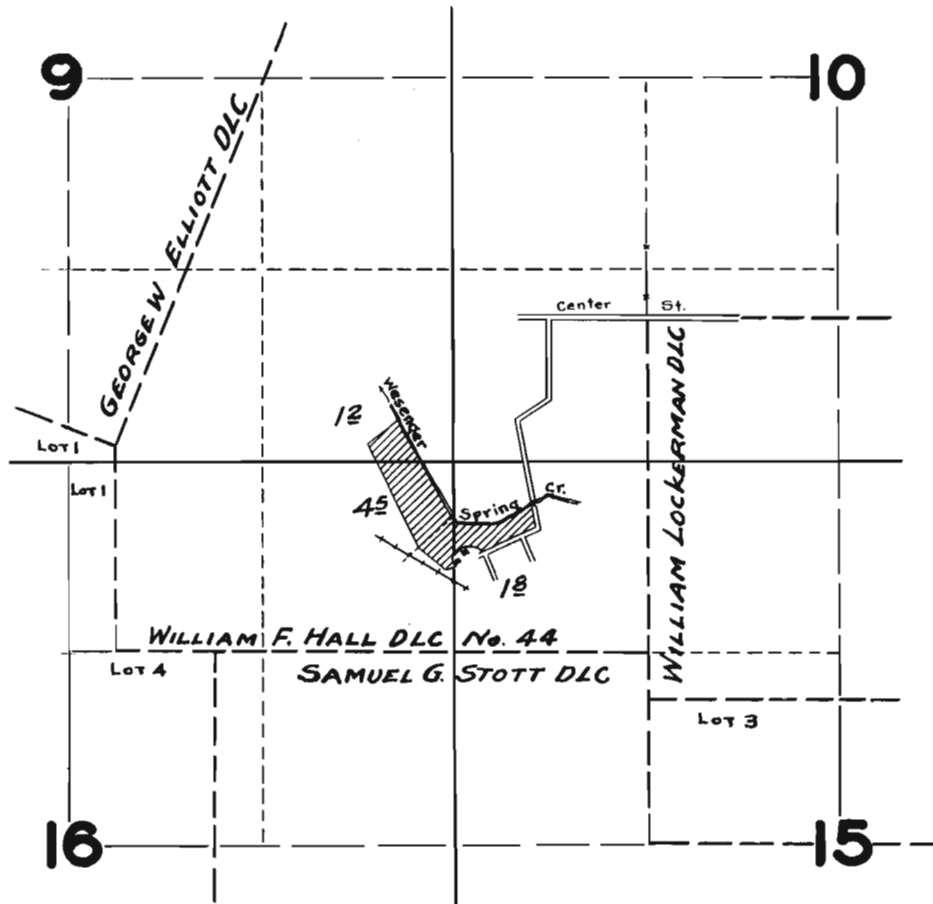

FINAL PROOF SURVEY UNDER

Application No. 14369 Permit No. 15011

IN NAME OF

Gelinda Casale Pesenti

Surveyed Aug. 5, 1942, by Geo. W. Pederman