


T. 6 S.. R. 8 W. W.M.

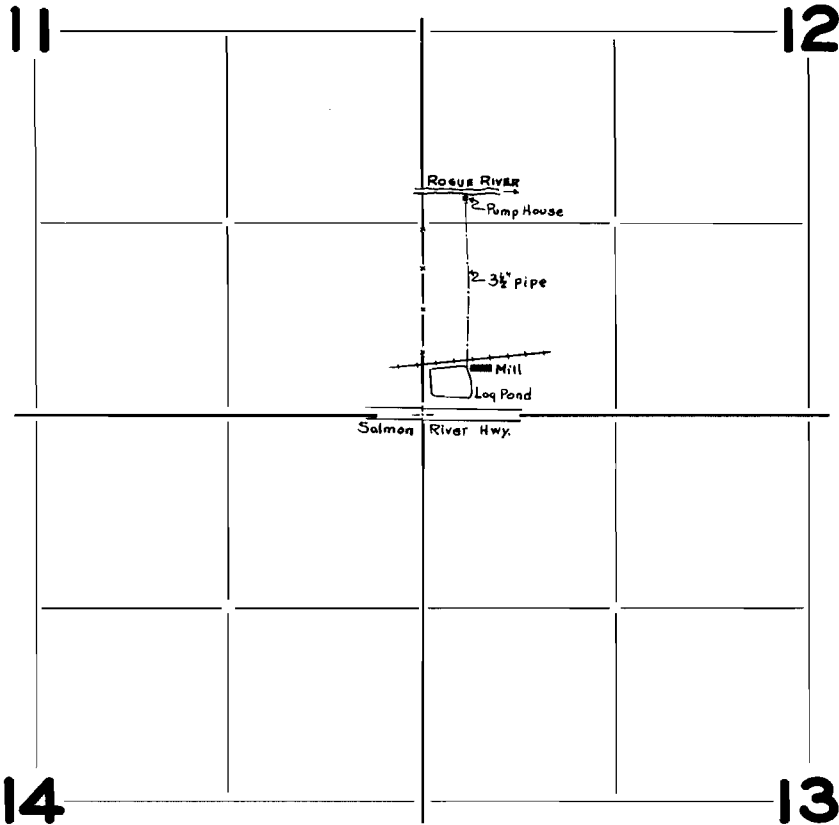

FINAL PROOF SURVEY

UNDER

Application No. *R-19456* *R-171*  
*19457* Permit No. *15049*

IN NAME OF

*Coastal Lumber Company*

Surveyed *June 19* 1942, by *Geo. W. Aderman*