


T. 6 S..R. 10 W. W.M.

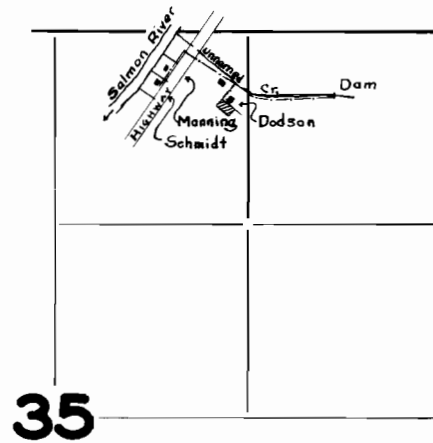

**FINAL PROOF SURVEY**  
UNDER

Application No. 19461 Permit No. 15050

IN NAME OF

Julia E. & Oliver M. Dodson;  
Anna H. Manning; Romer J. & Walter L. Schmidt

Surveyed Sept. 8, 1942, by Geo. W. Pademan