


T. 8 S., R. 11 W. W.M.

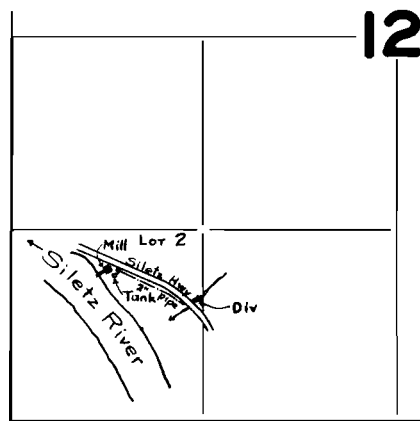

**FINAL PROOF SURVEY**  
UNDER

Application No. 19498 Permit No. 15099

IN NAME OF

Oscar Gilfillan

Surveyed Sept. 10, 1942, by Geo. Maderman