


T. 2 S., R. 3 W. W.M.

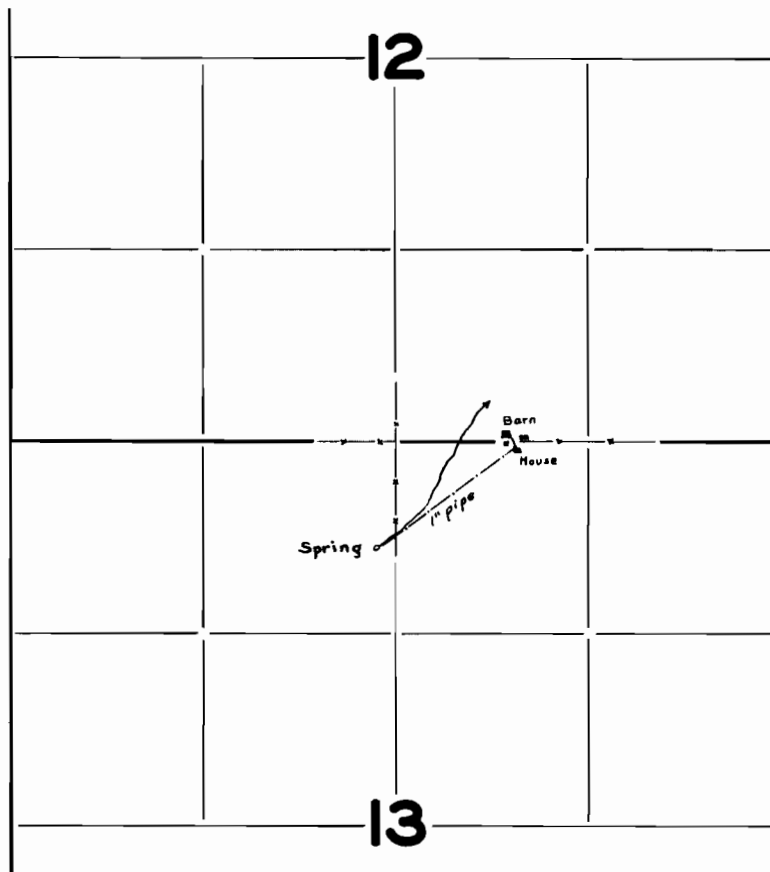

**FINAL PROOF SURVEY**  
UNDER

Application No. 19543 Permit No. 15130

IN FAVOR OF

Silas J. Bechen

Surveyed Aug 4 1942, by Geo. W. Maderman