


T. 1 S., R. 3 W. W.M.

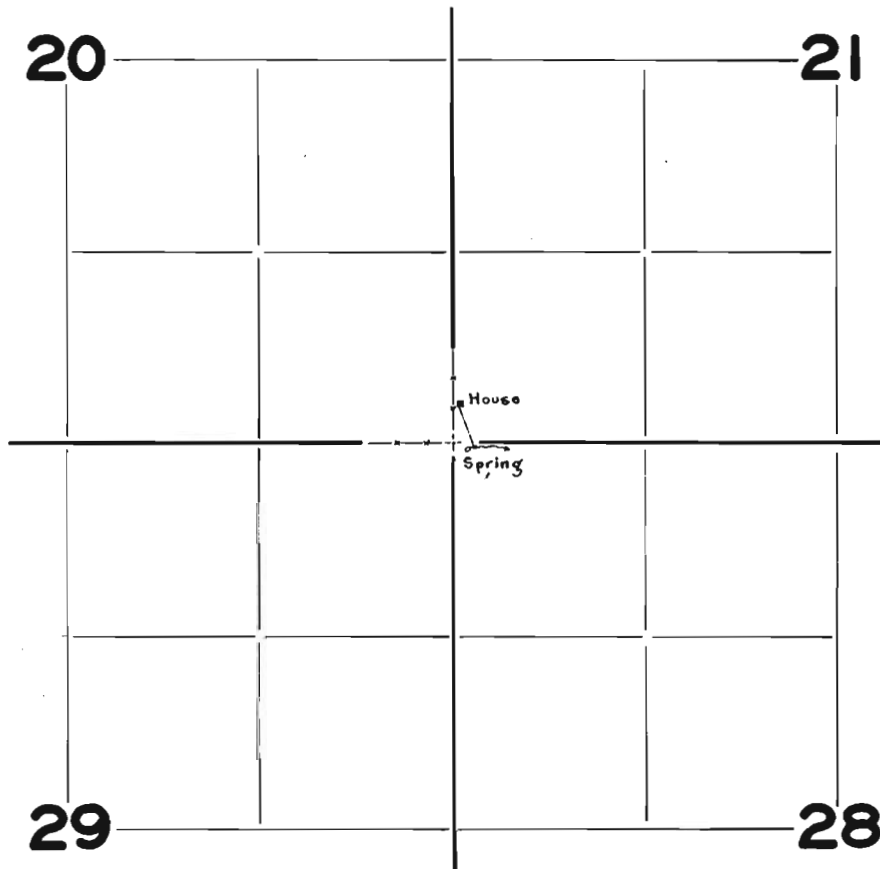

FINAL PROOF SURVEY
UNDER

Application No. 18389 Permit No. 15166

IN NAME OF

Oliver W. Newman

Surveyed Aug. 11, 1942, by Leah O. Mademan