


T. 11 S., R. 3 W. W.M.

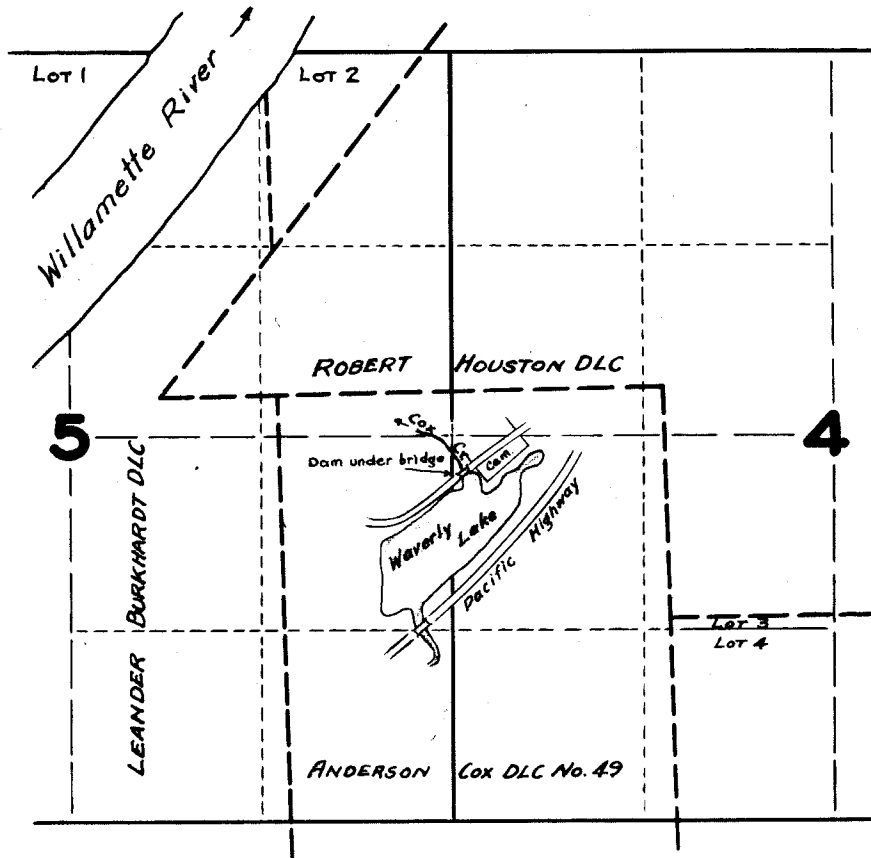

**FINAL PROOF SURVEY**  
UNDER

Application No. 19626 Permit No. 15201

IN NAME OF

Oregon State Highway Comm.

Surveyed Sept. 14, 1942, by Geo. U. Maderman