


T. 3 S., R. 4 W. W.M.

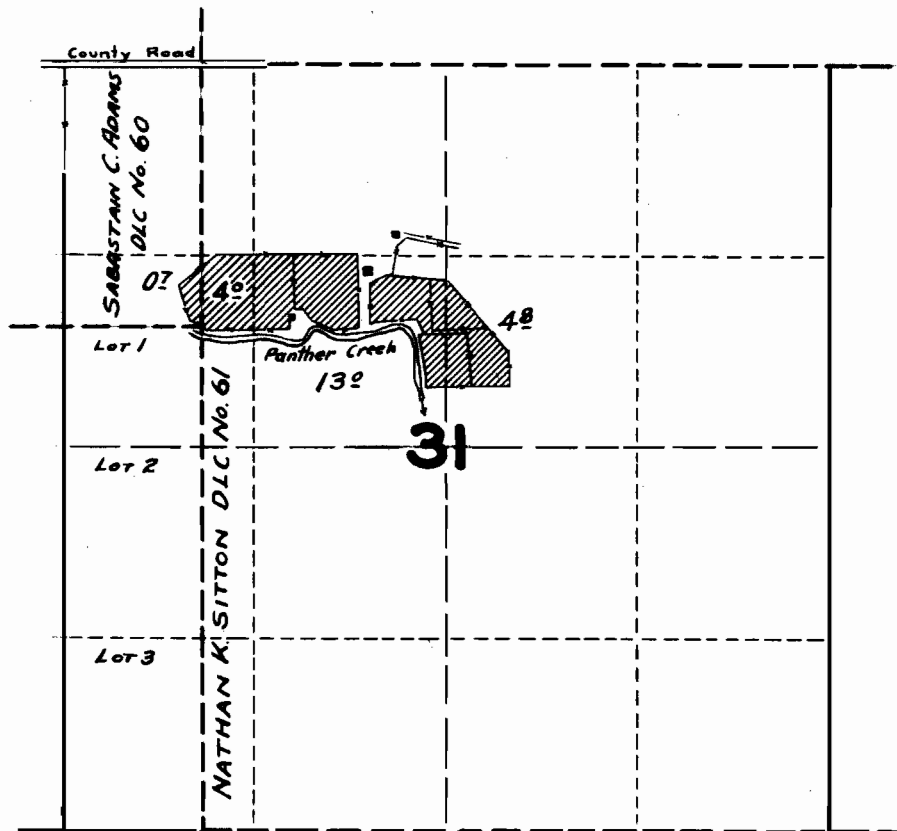

**FINAL PROOF SURVEY
UNDER**

Application No. 15573 Permit No. 11463

IN NAME OF

E. D. Sitton

Surveyed Aug. 18, 1942. by Geoff Naderman