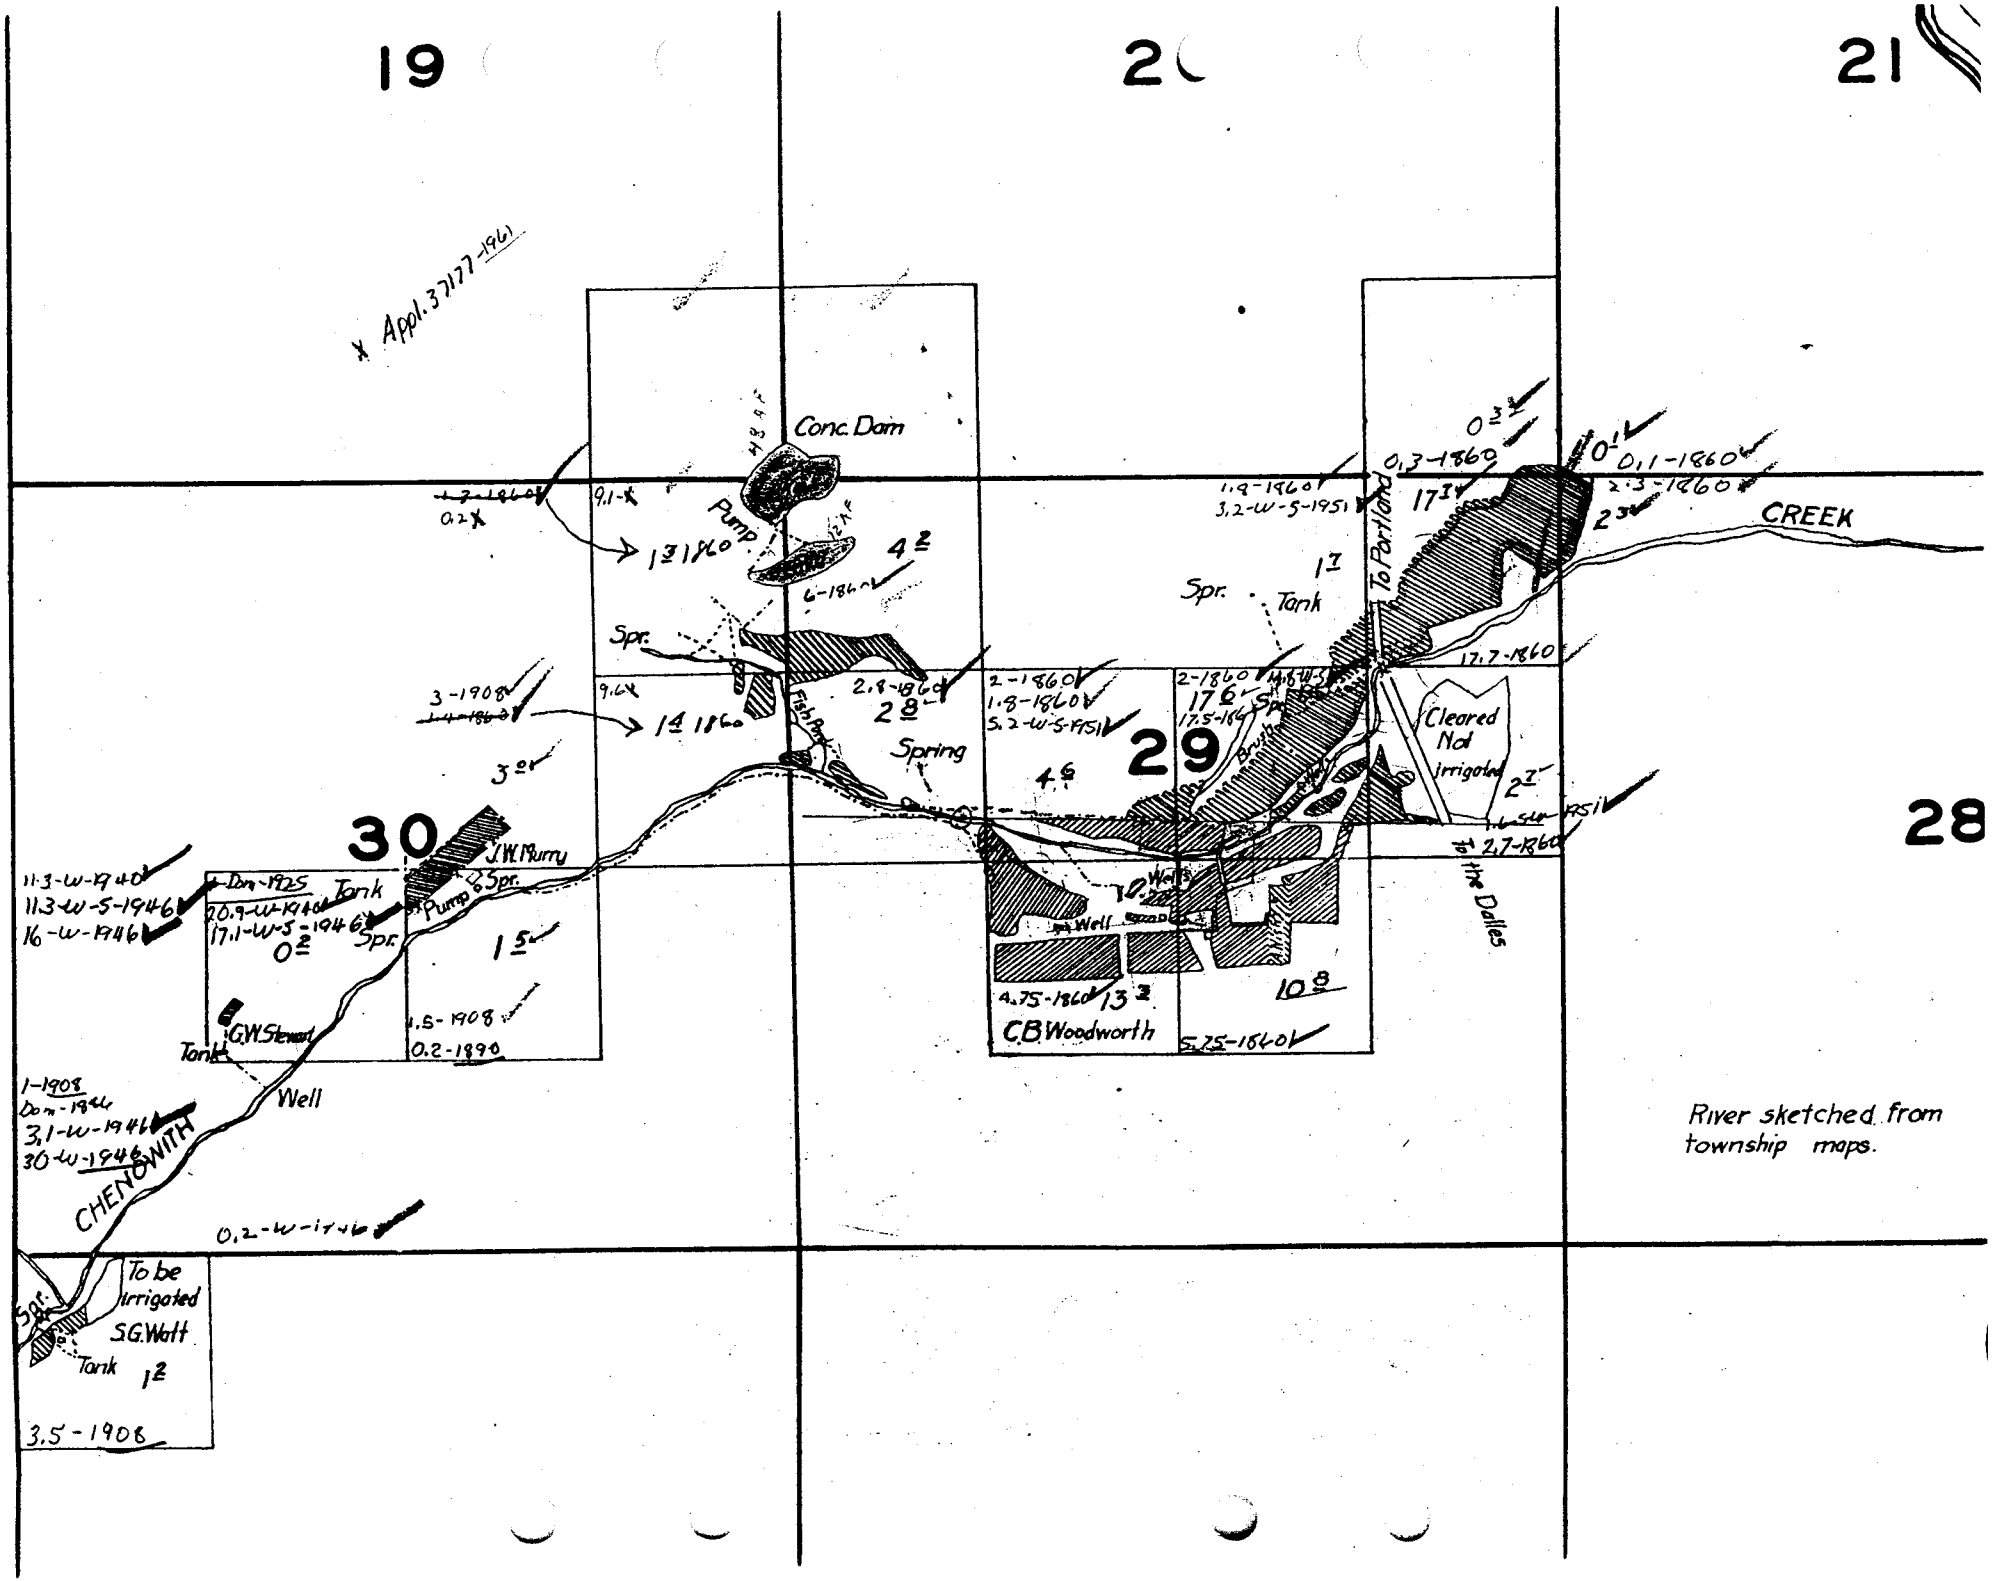
19
20
21
28
29
30
X Appl. 37177-1961
Conc. Dam
Pump
Spr.
Tank
Spring
Fish Pond
Brush
Cleared Not Irrigated
To Portland
To The Dalles
CREEK
J.W. Murry
G.W. Stewart
Well
CHENOWITH
To be irrigated S.G. Watt
C.B. Woodworth
River sketched from township maps.