


x Appl. 32177-1961

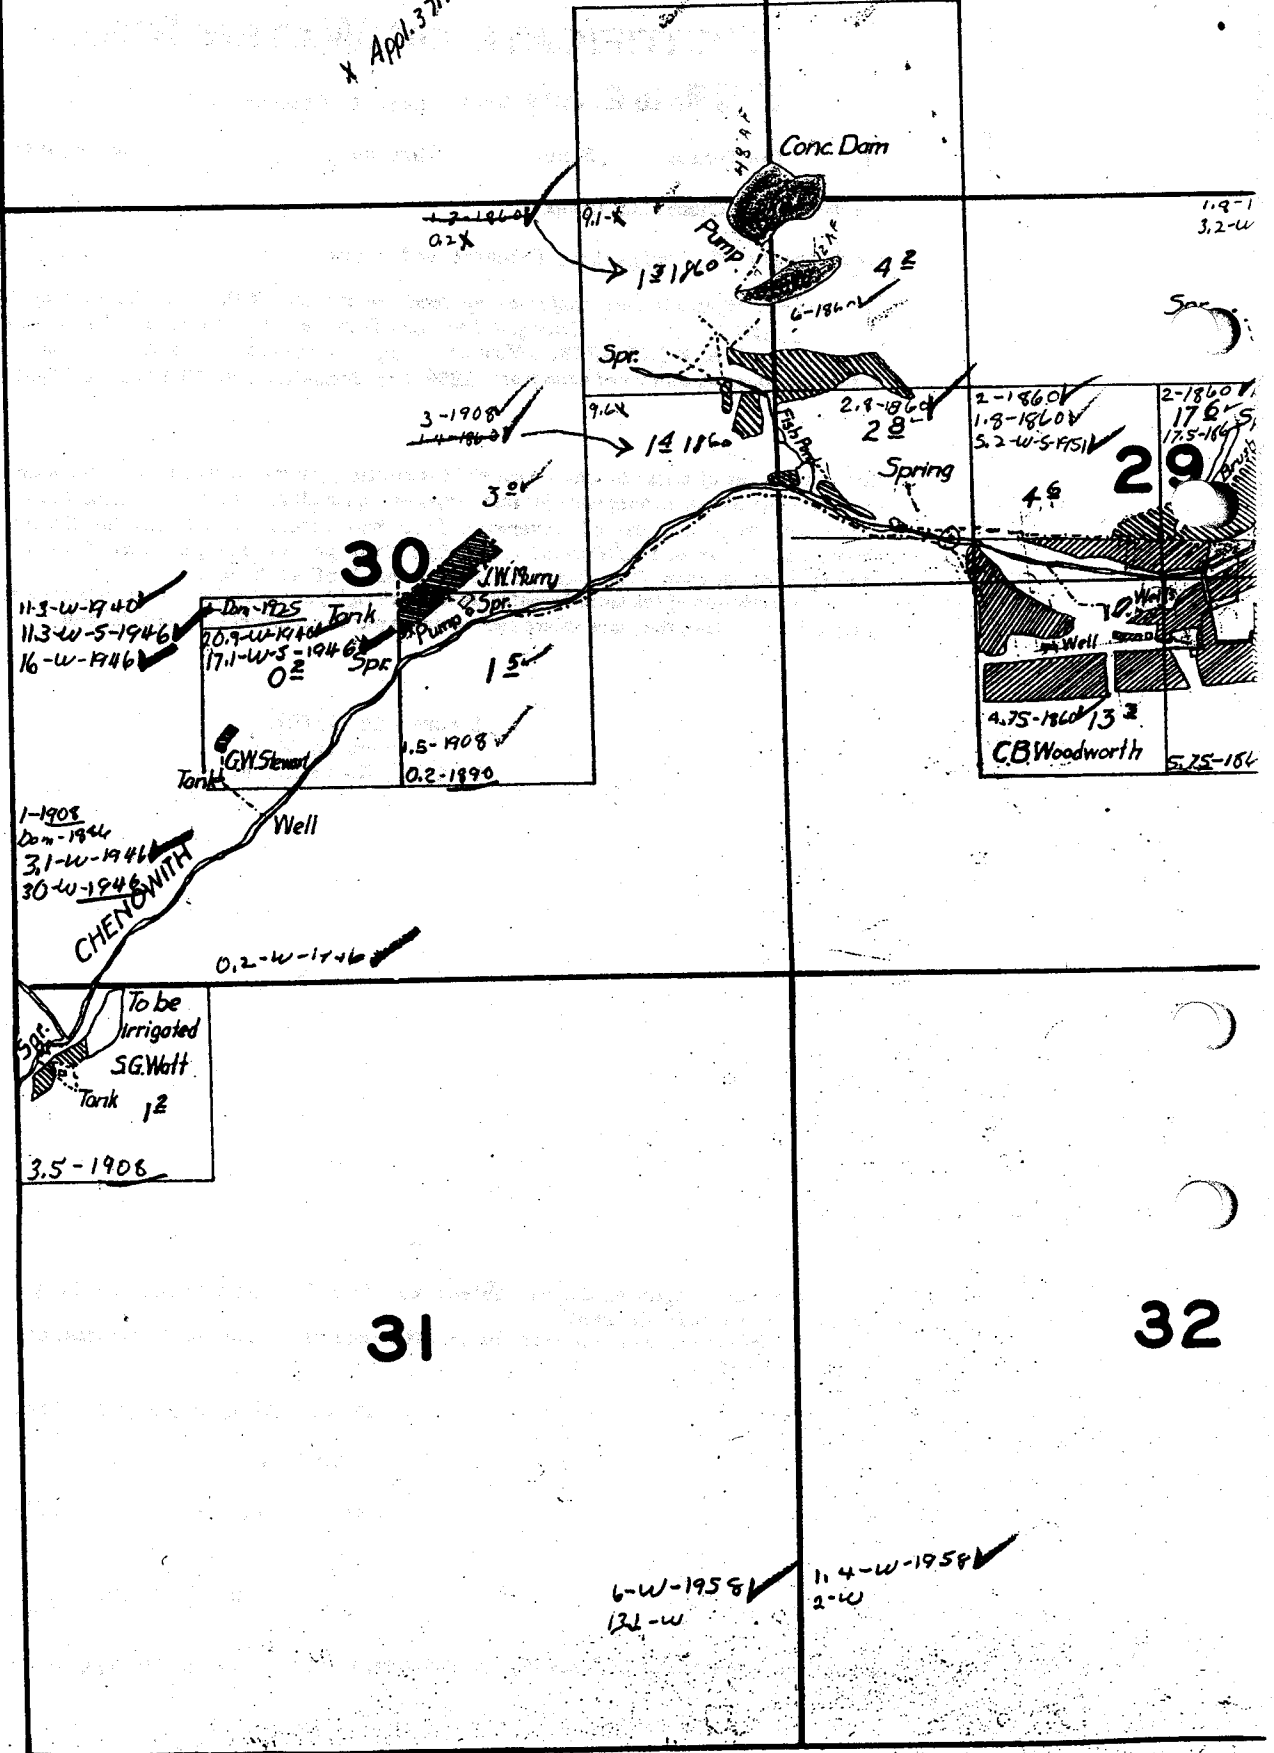

30

29

31

32