


T. 27 S., R. 6 W. W.M.

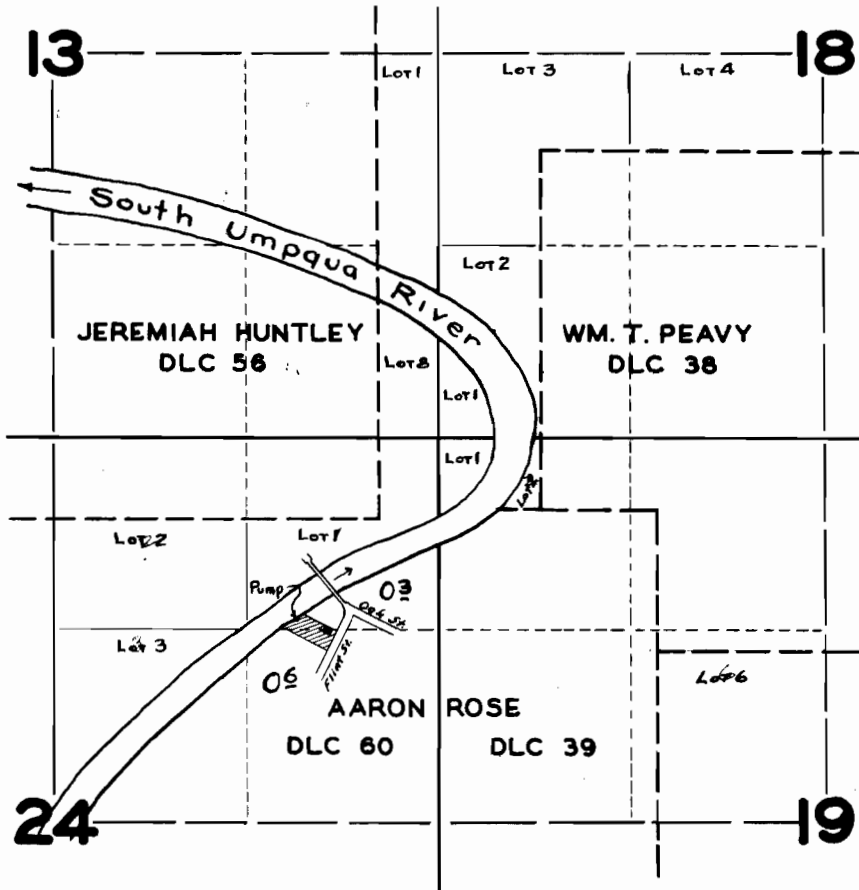

FINAL PROOF SURVEY
UNDER

Application No. 18176 Permit No. 13810

IN NAME OF

C. E. Banning

Surveyed Sept. 11, 1943, by Carl Pederman