


# T. 20 S., R. 4 W. W.M.

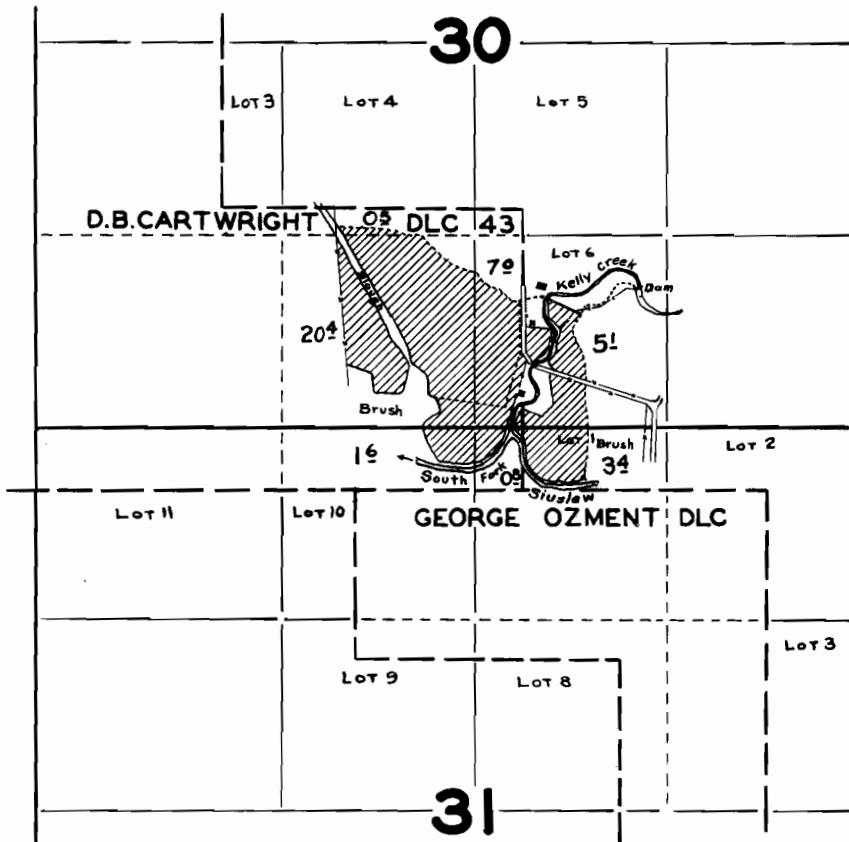

*Note: This survey includes the lands irrigated under permit 423, cart. 827*

## FINAL PROOF SURVEY UNDER

Application No. 18281 Permit No. 13930

IN NAME OF

Terry McCornack

Surveyed Sept. 15 1943, by Geo. W. Naderman