


T. 8 S., R. 3 W. W.M.

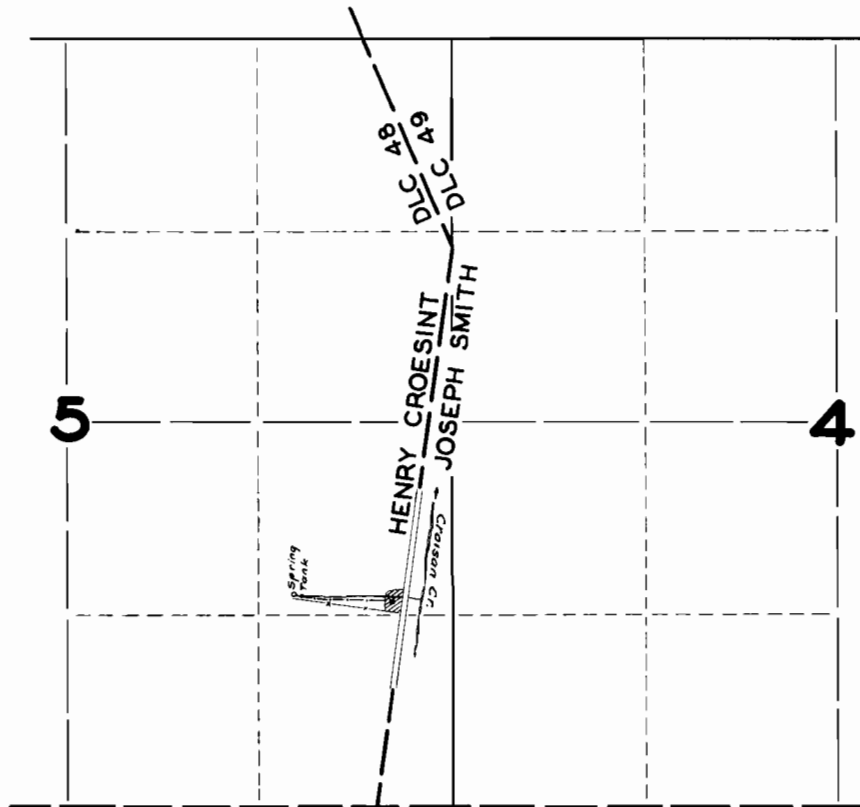

**FINAL PROOF SURVEY
UNDER**

Application No. 19711 Permit No. 15287

IN NAME OF

Charlotte G. Jones

Surveyed July 26 1943, by Geor. Maderman