




S.

Range 26 E. W. M.

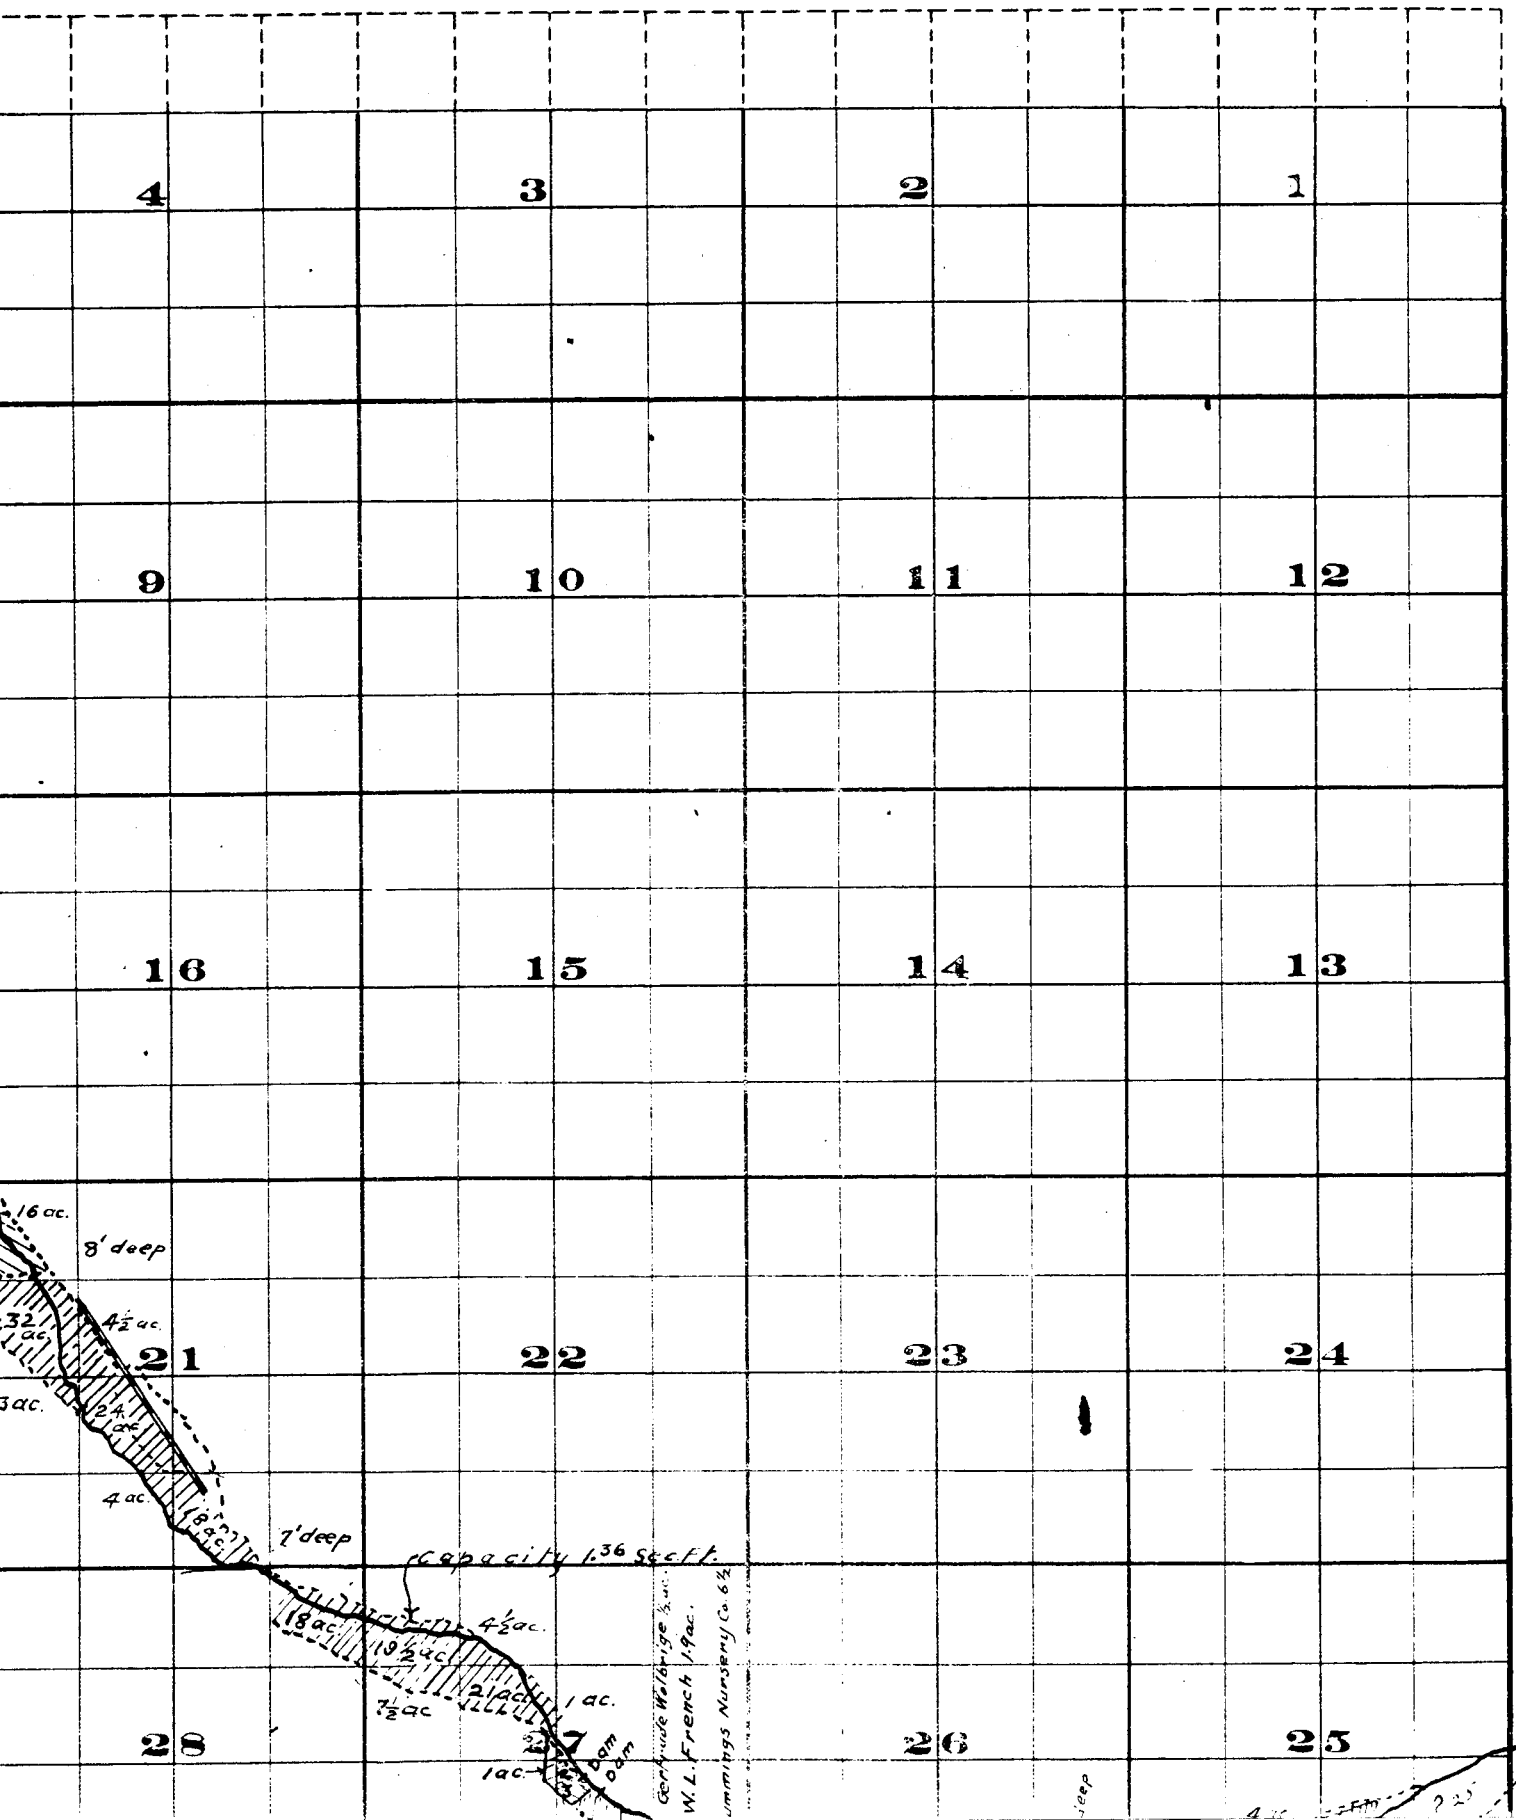

Township 2 S. ,

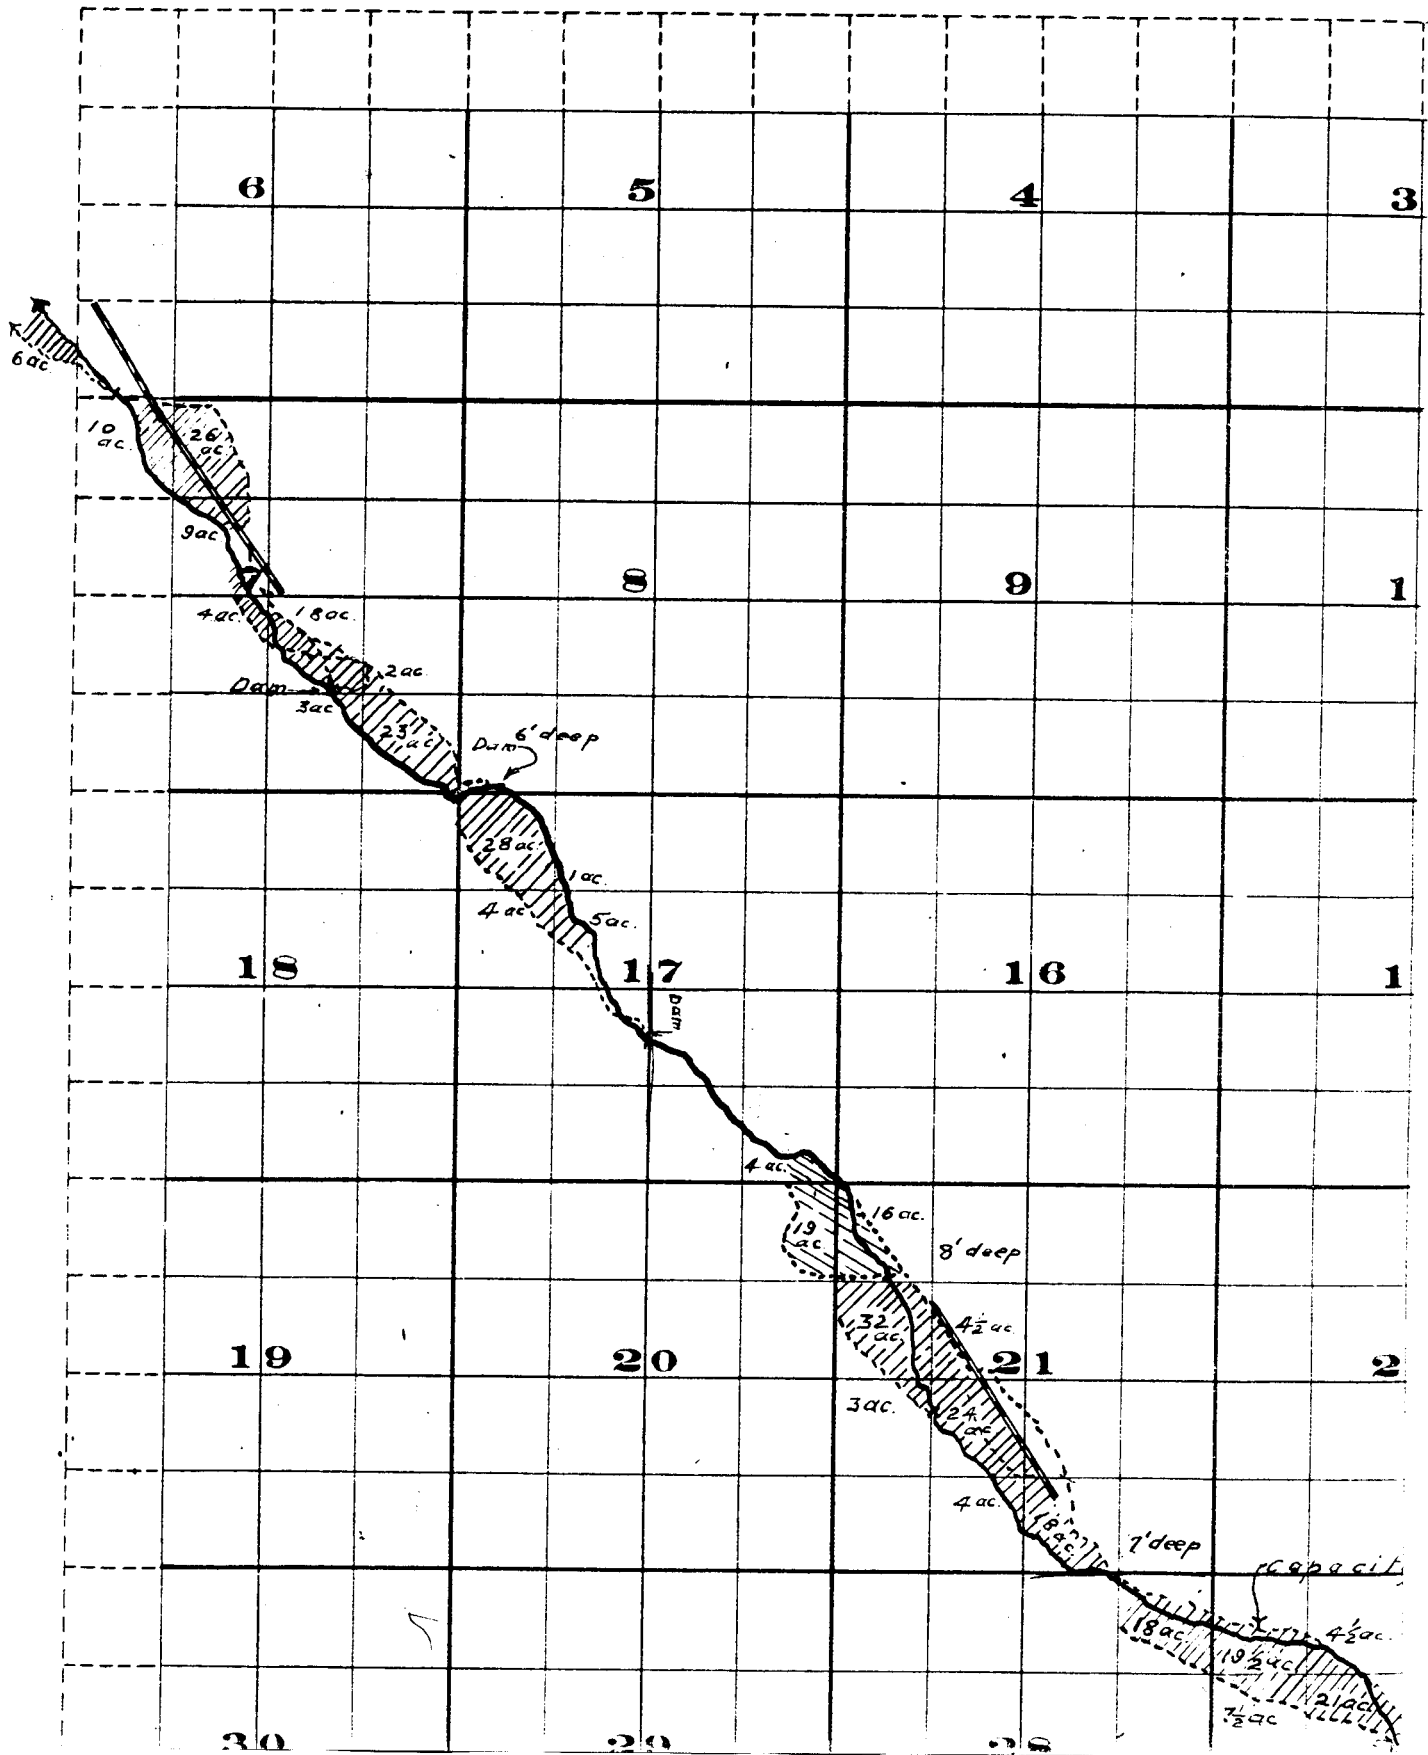

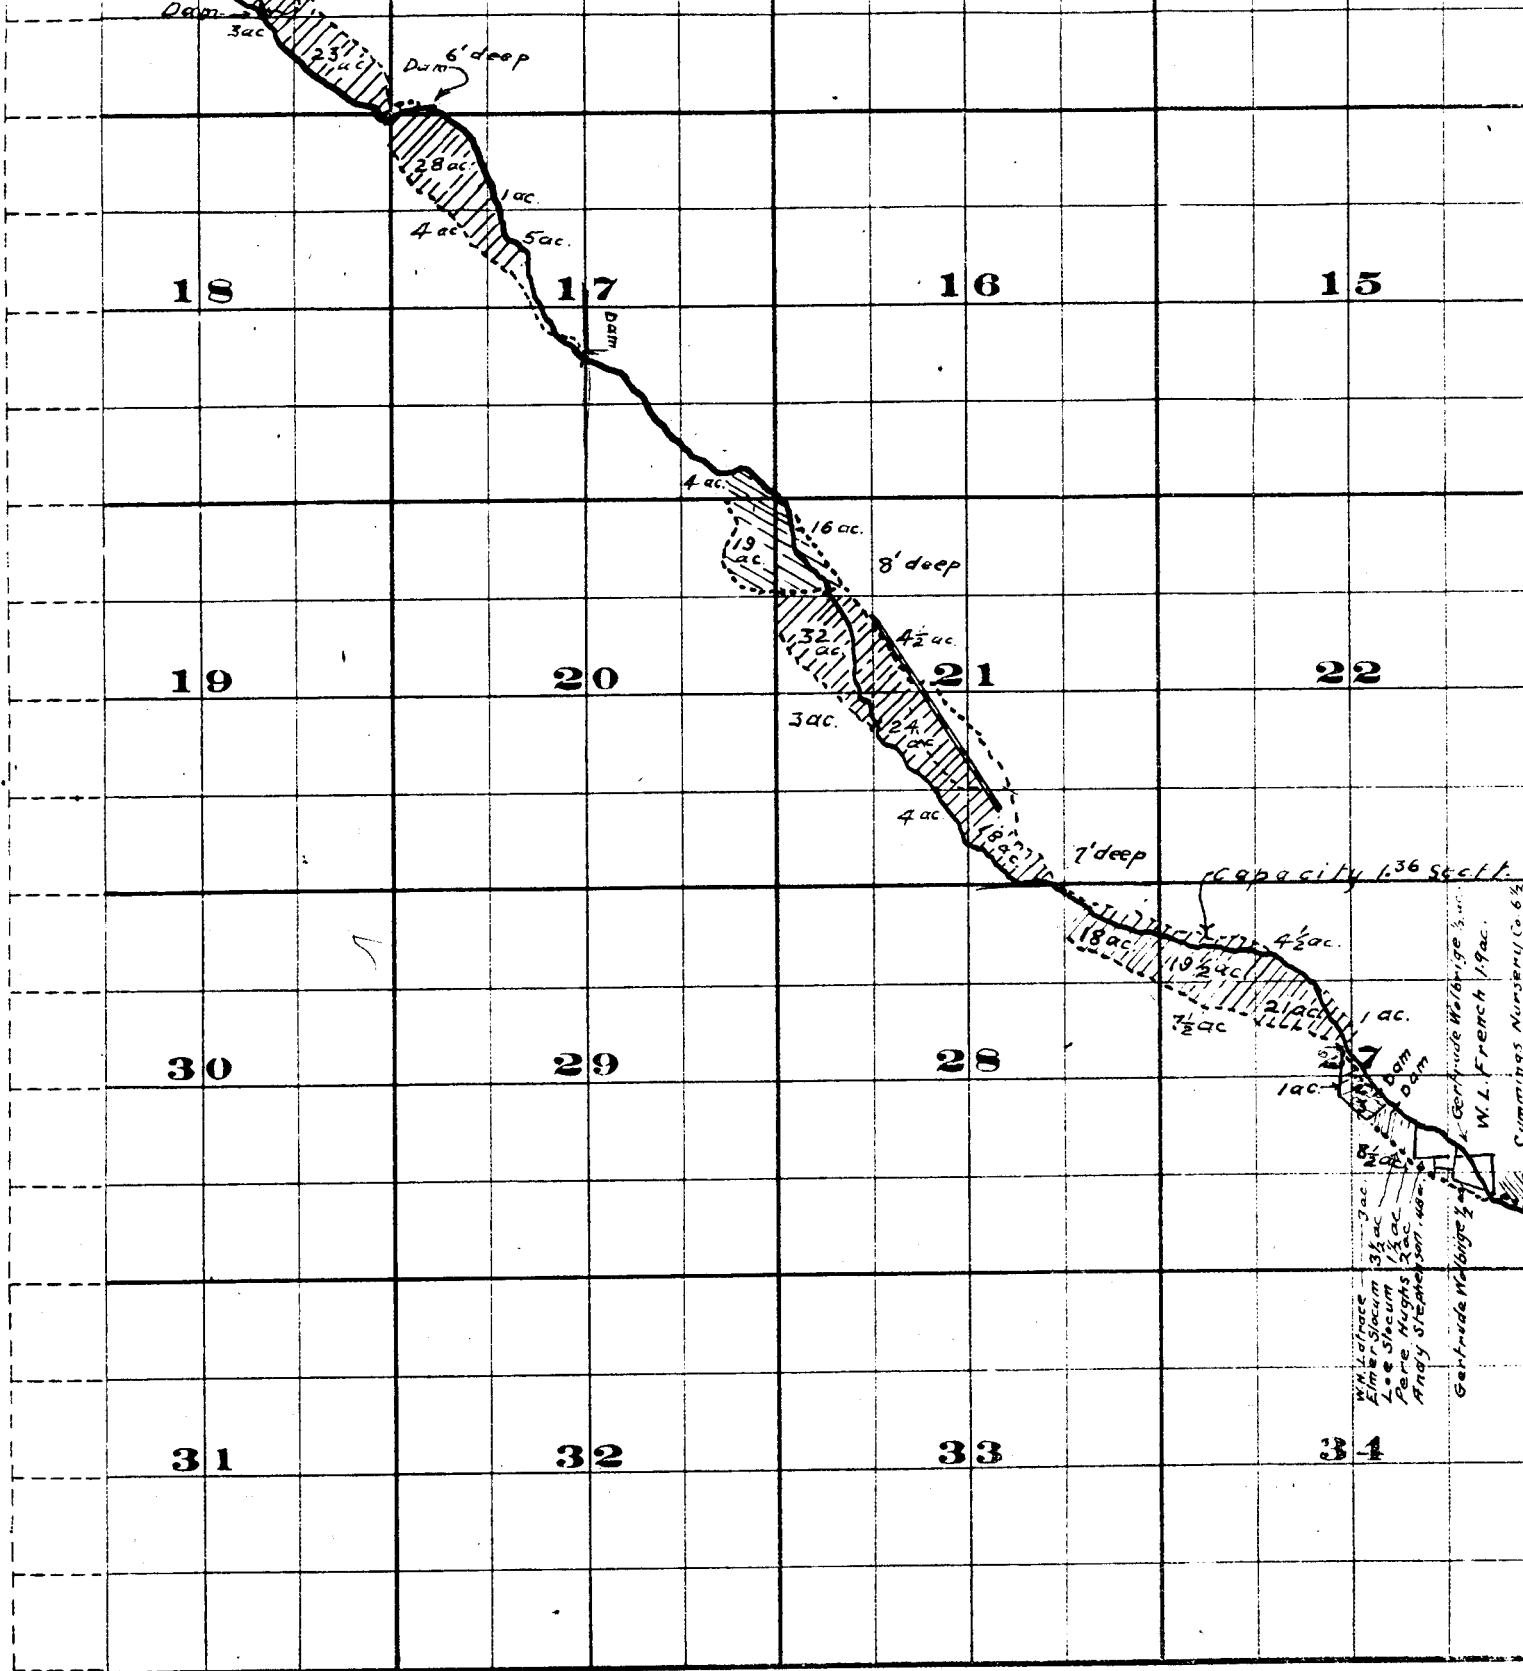


THE S. A. BRISTOL CO., PRINTERS & BOOK-BINDERS CHATTANOOGA, TENN.

Surveyed by R.D. Cooper July 1909

John H. Lewis - State Engineer.

Examined July 14, 1909.

L

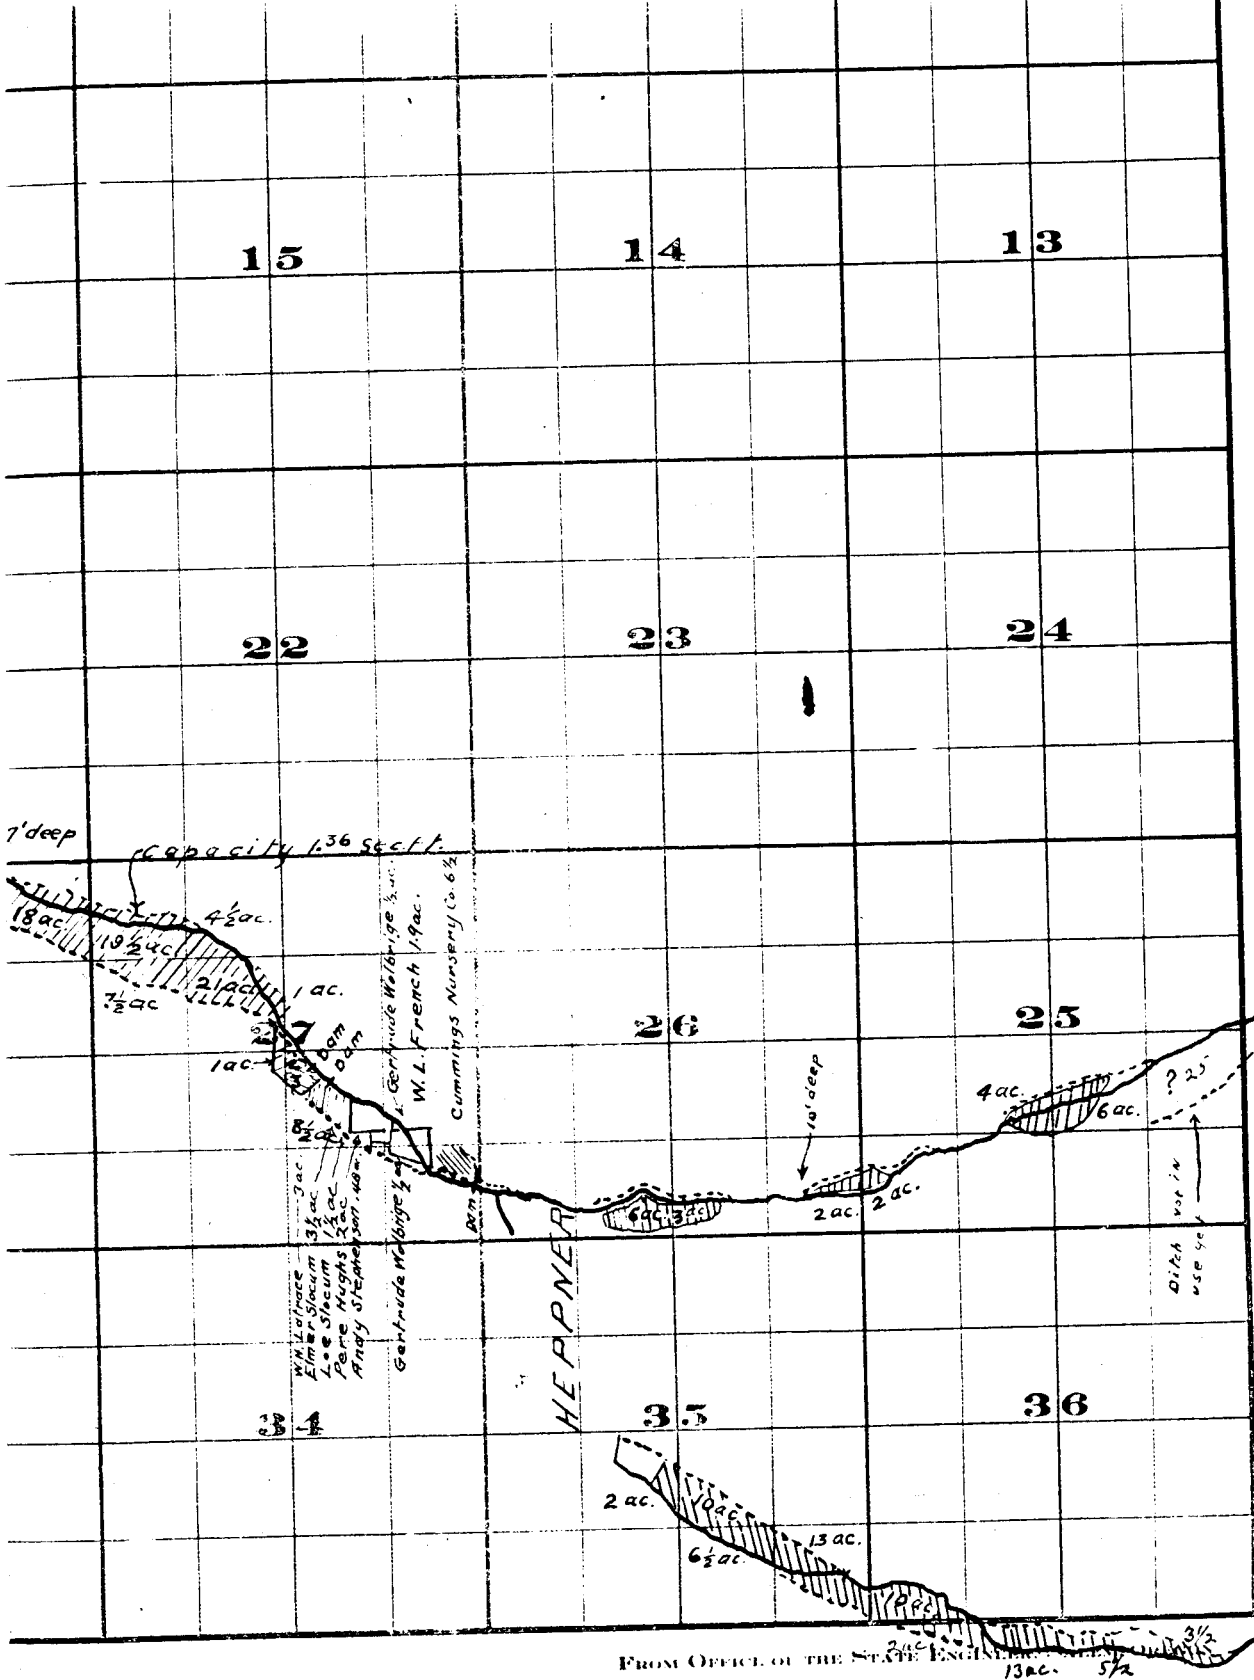

Willow Creek Adjudication

Part 35.26

25.26