


T. 31 S., R. 3 W. W.M.

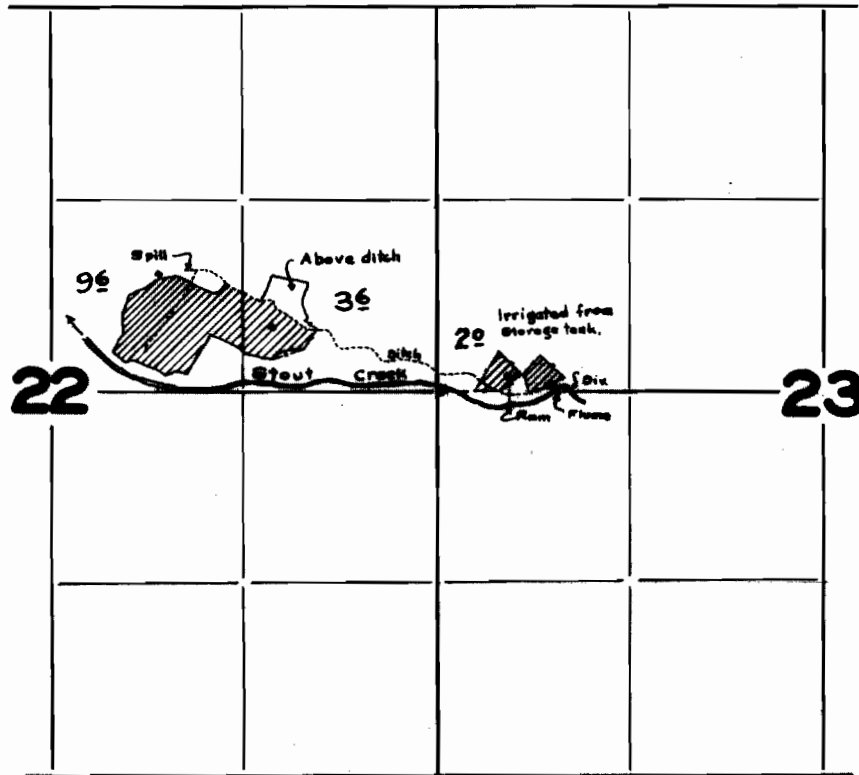

FINAL PROOF SURVEY
UNDER

Application No. 15187 Permit No. 11116

IN NAME OF

Mrs. Sarah Neiderhauser

Surveyed Sep. 6, 1943, by Geo. Mademan