


T. 25 S., R. 6 W. W.M.

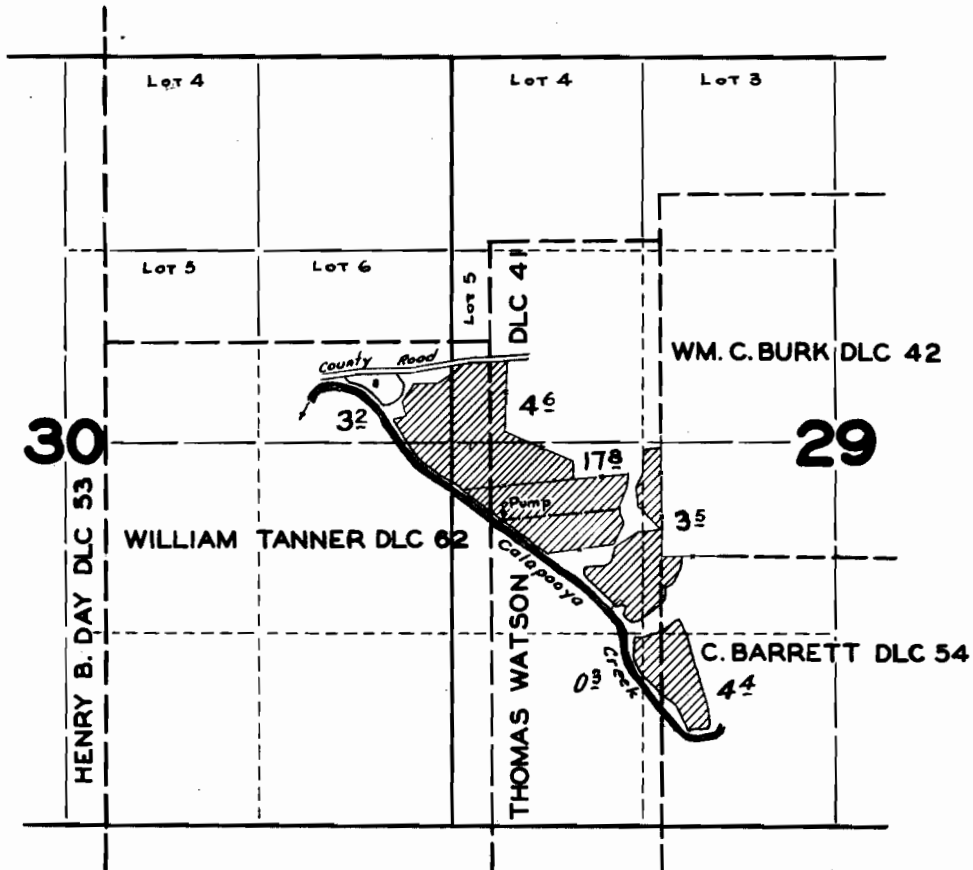

FINAL PROOF SURVEY UNDER

Application No. 15642 Permit No. 11515

IN NAME OF

Lula C. Gorrell

Surveyed Sept. 10 1943, by Carl Daderman