


T. 4 S., R. 2 E. W.M.

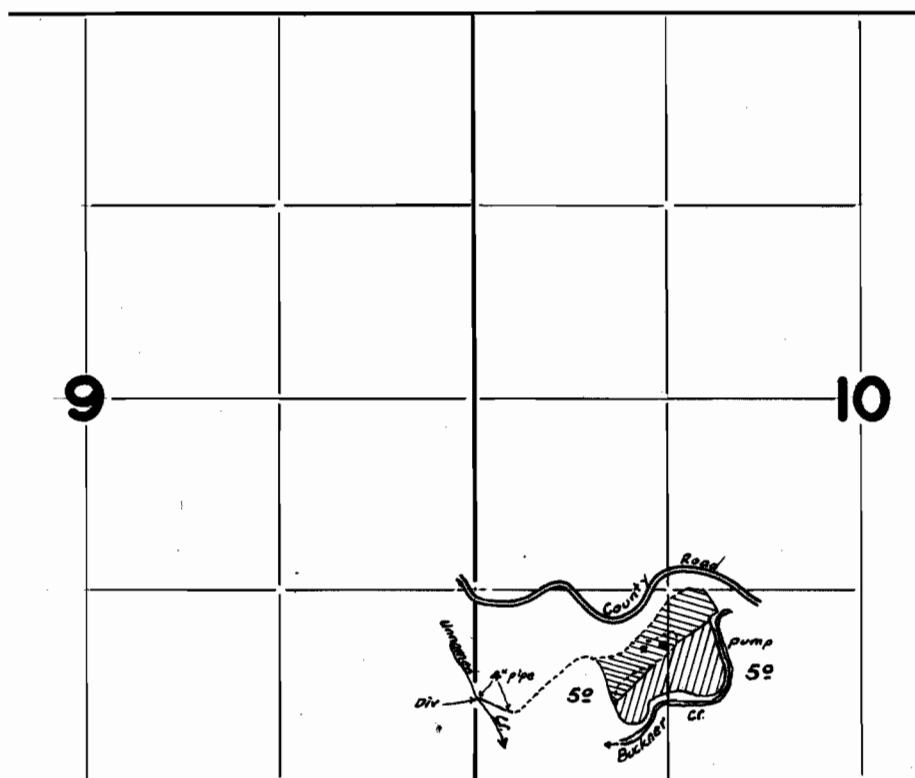

**FINAL PROOF SURVEY
UNDER**

Application No. 16056 Permit No. 11869

IN NAME OF

B. F. Shannon

Surveyed July 24 1942, by Geor. Anderson