


T. 25 S., R. 13 W. W.M.

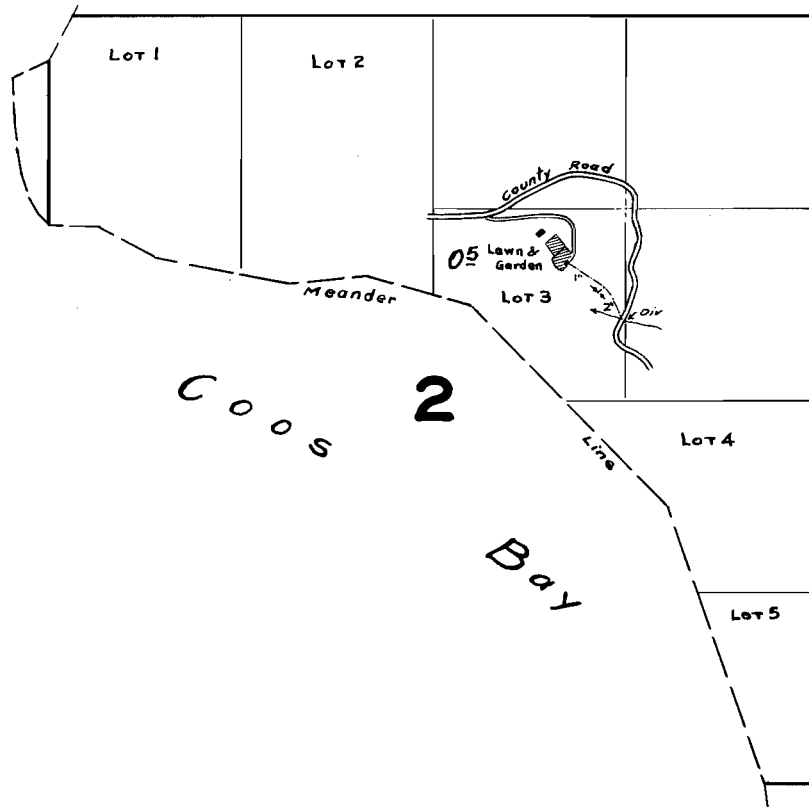

**FINAL PROOF SURVEY
UNDER**

Application No. 16228 Permit No. 12048

IN NAME OF

Hans Selfors

Surveyed Aug. 14 1943, by Geo. W. Maderman