


T. 26 S., R. 6 W. W.M.

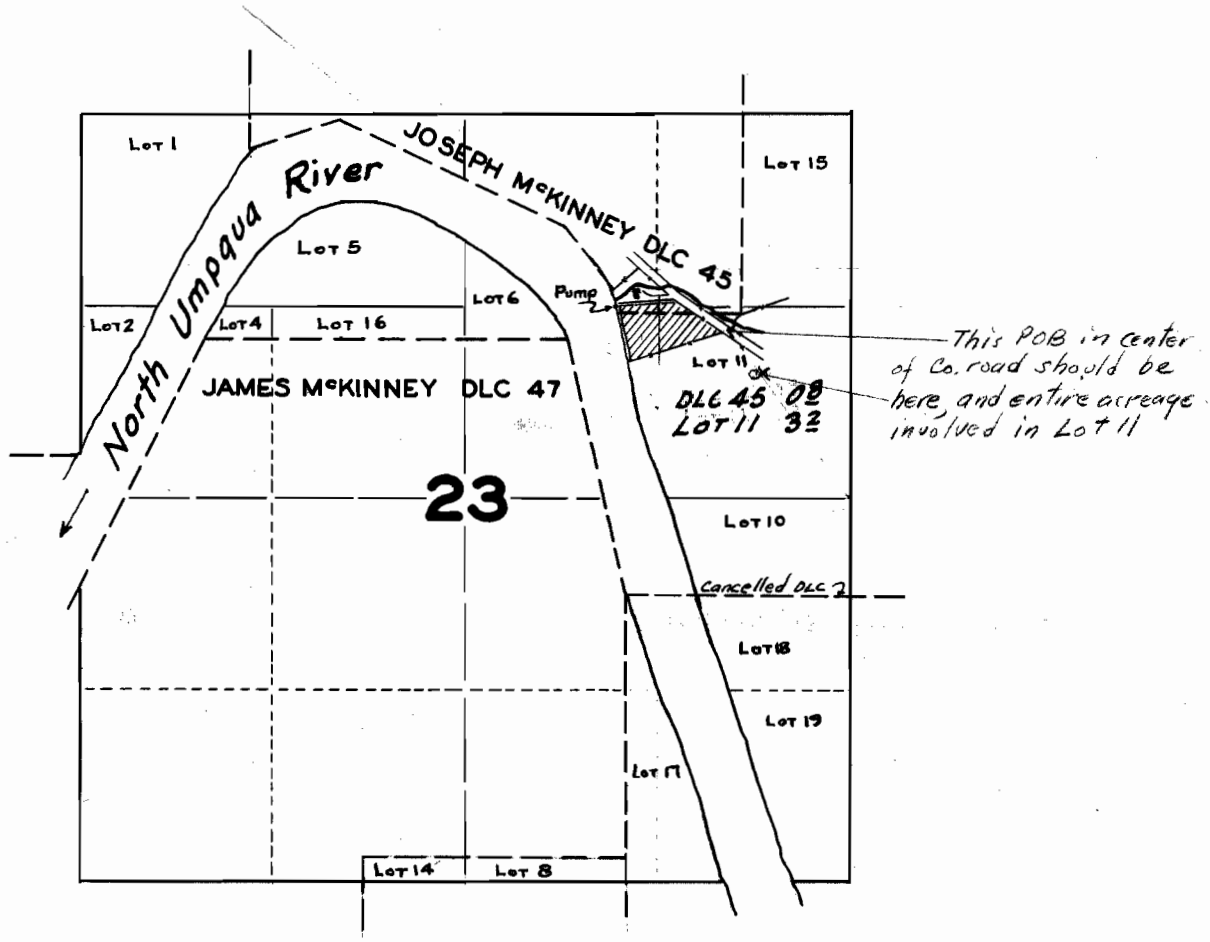

**FINAL PROOF SURVEY
UNDER**

Application No. 16268 Permit No. 12086

IN NAME OF

Ernest Theodor Unrath

Surveyed Sept. 10 1943, by Geo. W. Mademan