


T. 7 S., R. 4 W. W.M.

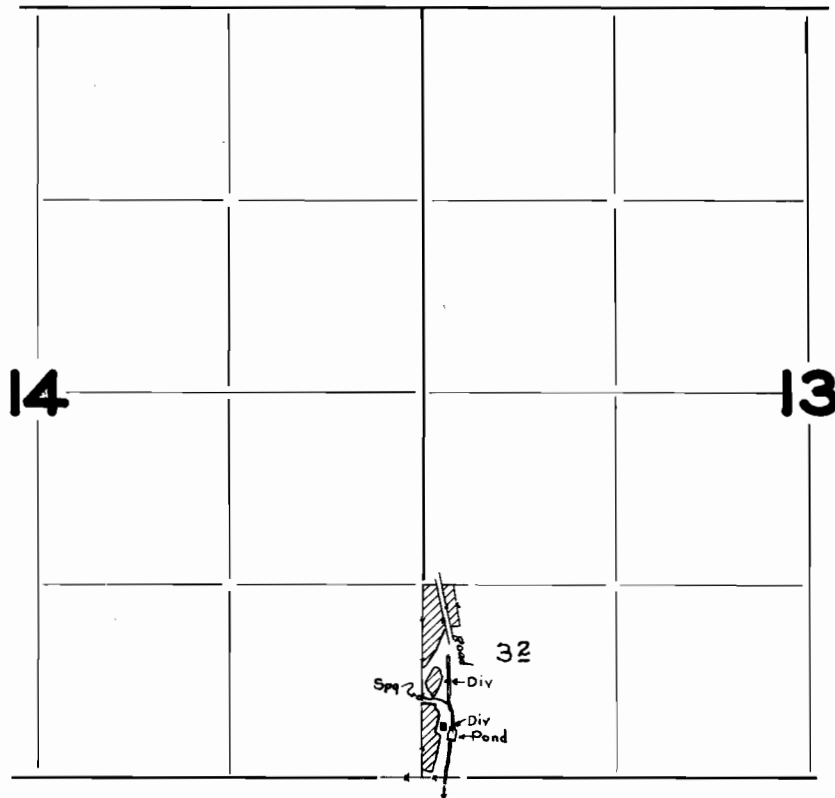


**FINAL PROOF SURVEY**  
UNDER

Application No. 16316 Permit No. 12108

IN NAME OF

Marie S. Tavenner

Surveyed June 18 1942, by Geo. Mademan

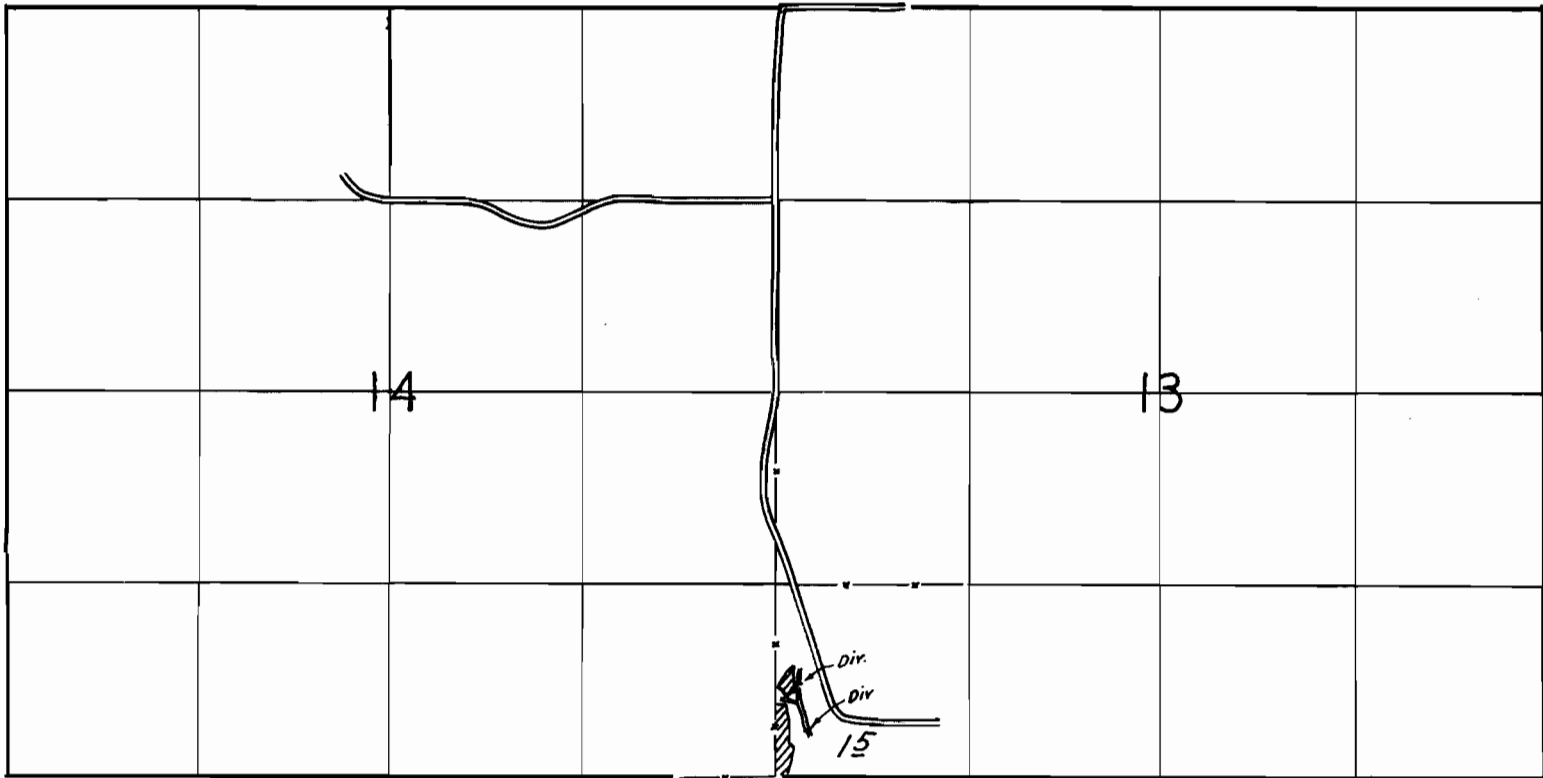

**FINAL PROOF SURVEY**

UNDER

Application No. 16316 Permit No. 12108

IN NAME OF

Marie S. Tavenner

Surveyed Apr 28, 1941, by E. Humming