


T. 4 S., R. 10 W. W.M.

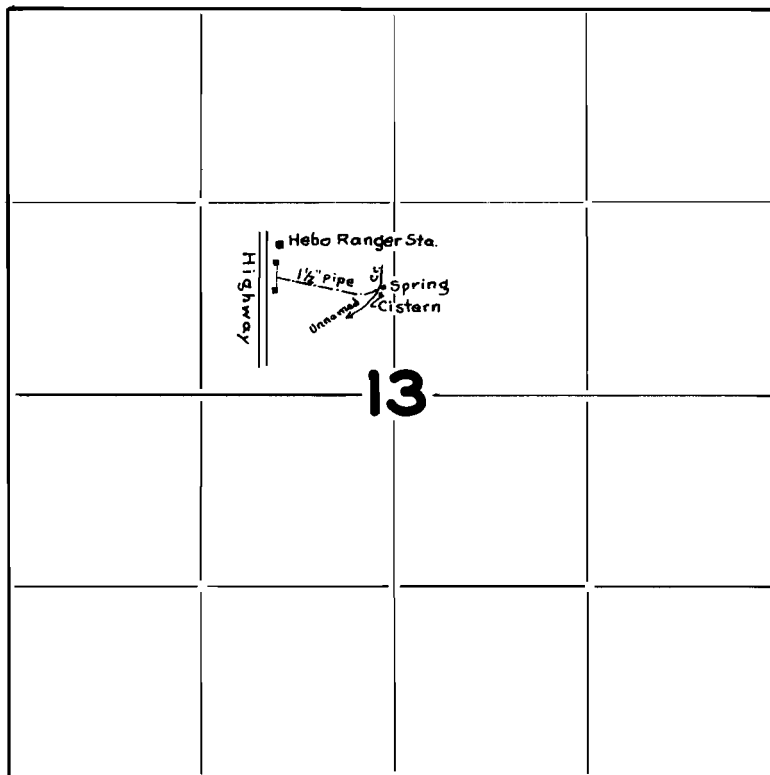

FINAL PROOF SURVEY UNDER

Application No. 16972 Permit No. 12726

IN FAVOR OF

Ollie F. Nyswaner

Surveyed Aug. 22 1942, by Geoff Naderman