


T. 18 S., R. 10 W. W.M.

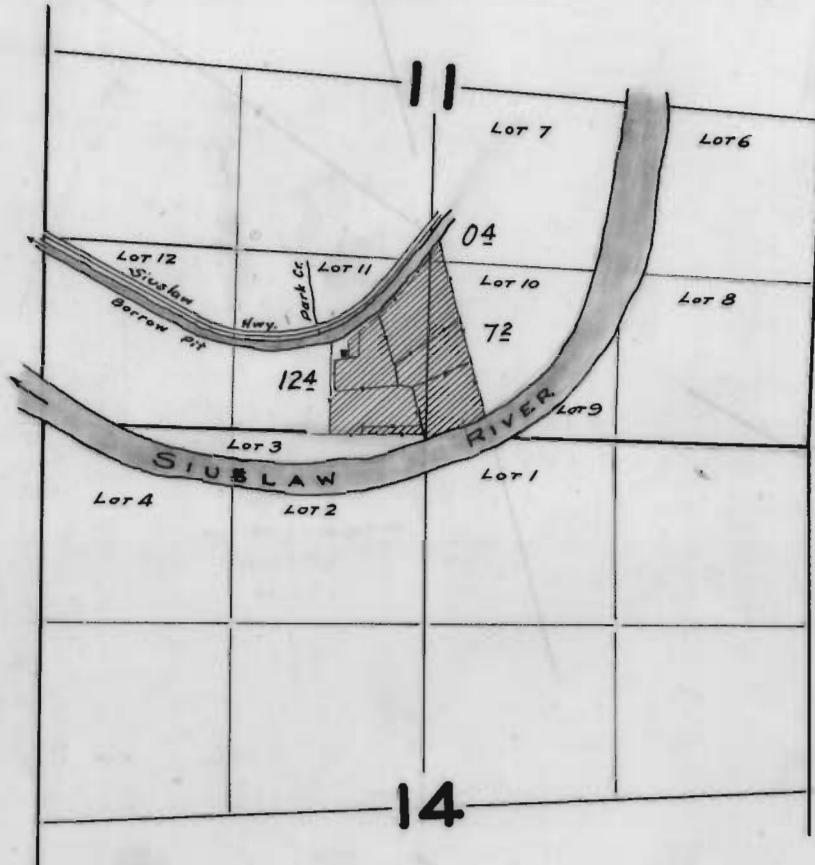

FINAL PROOF SURVEY
UNDER

Application No. 17114 Permit No. 12844

IN NAME OF

Peter S. Rice

Surveyed Aug. 11, 1943, by Geo. W. Anderson