


T. 20 S., R. 1 W. W.M.

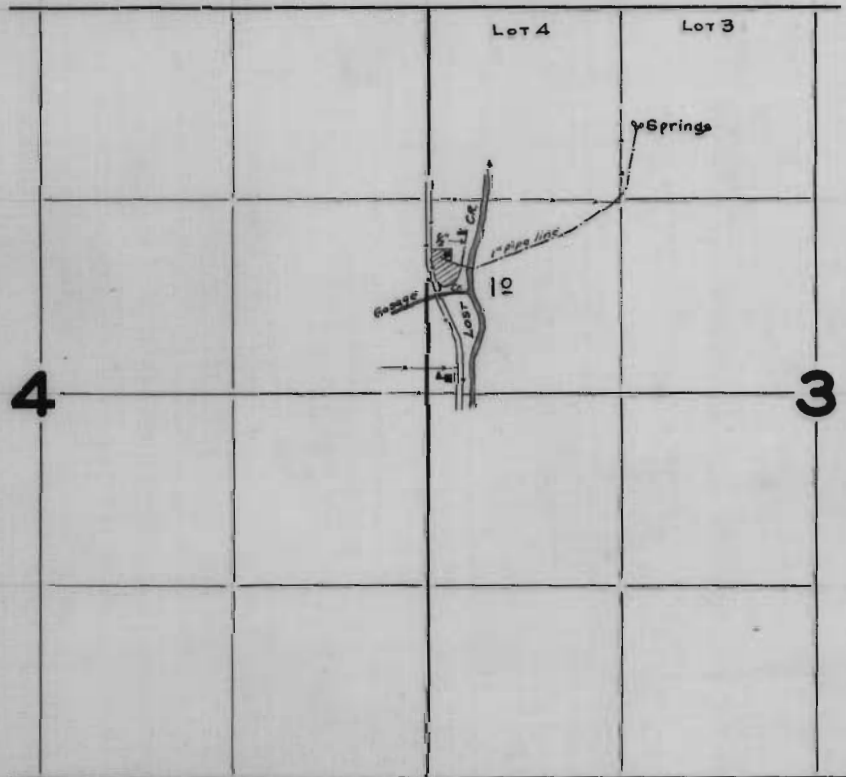

FINAL PROOF SURVEY
UNDER

Application No. 17130 Permit No. 12854

IN NAME OF

Mrs. Mae Barnett

Surveyed Sept 16 1943, by Geo W. Mademan