


T. 27 S., R. 6 W. W.M.

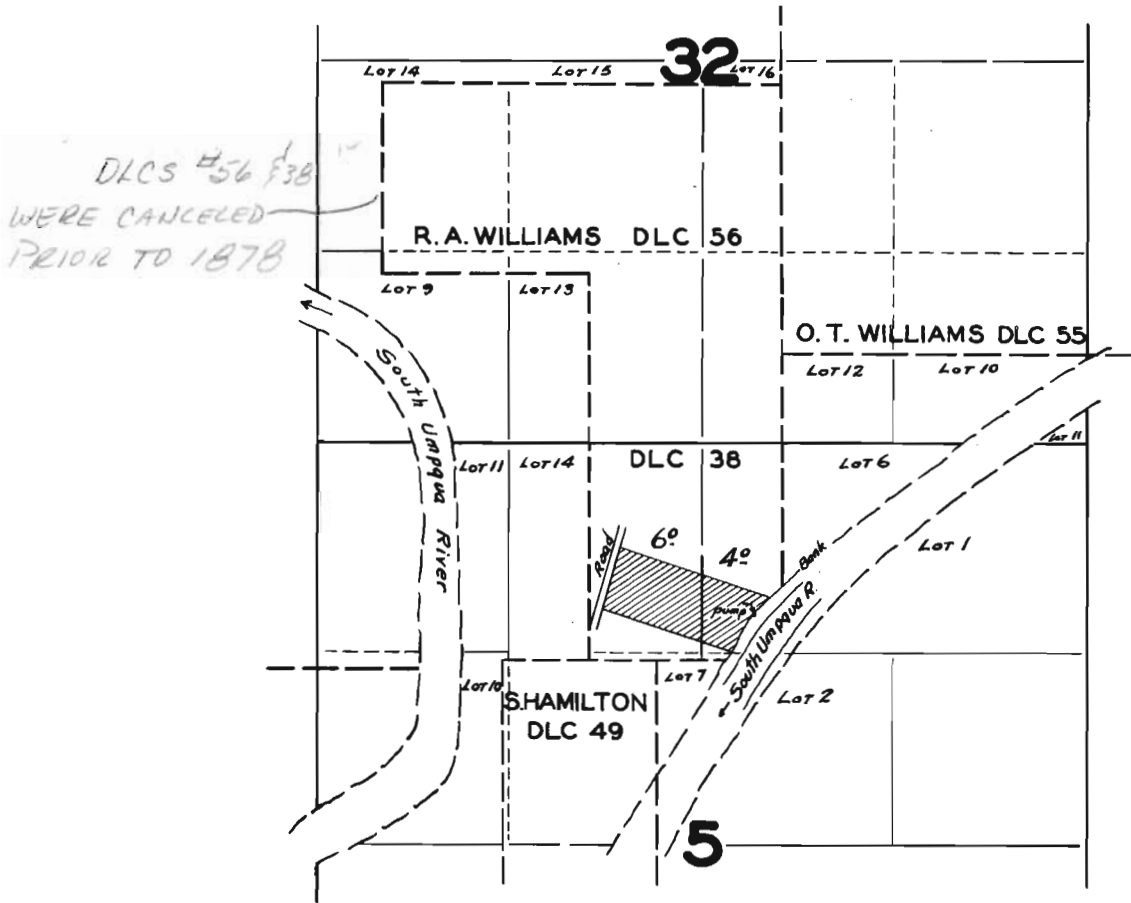

FINAL PROOF SURVEY  
UNDER

Application No. 17213 Permit No. 12935

IN NAME OF

A.A. Young

Surveyed Sept. 10 1943, by Carl Maderman