


T. 31 S., R. 15 W. W.M. .

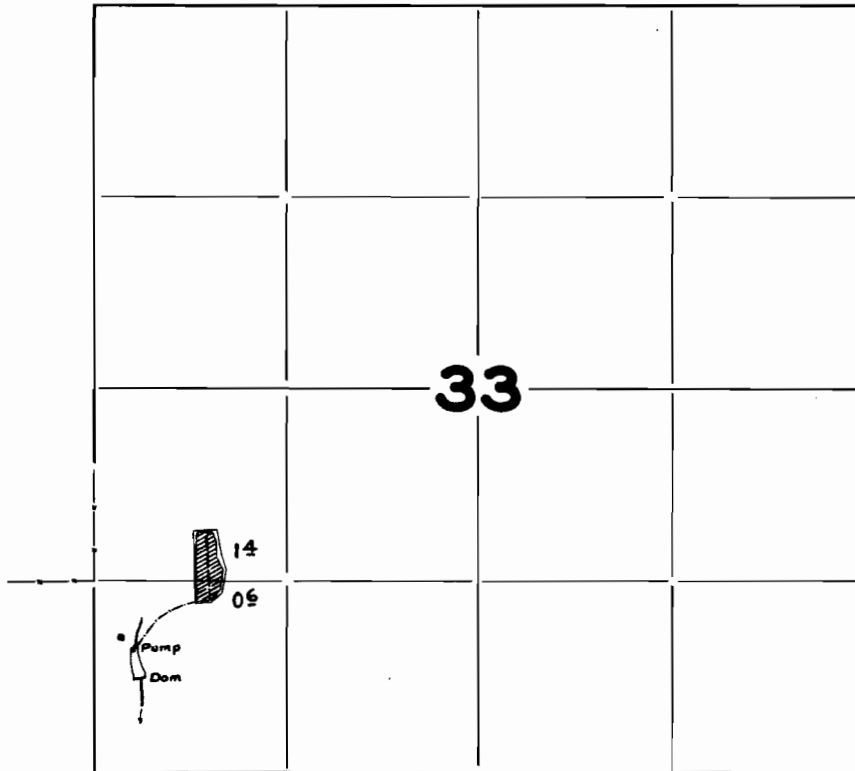

**FINAL PROOF SURVEY
UNDER**

Application No. 17250 Permit No. 12957

IN NAME OF

M. Fogle

Surveyed Sept 3 1943, by Geo. D. Pederman