


T. 25 S., R. 12 W. W.M.

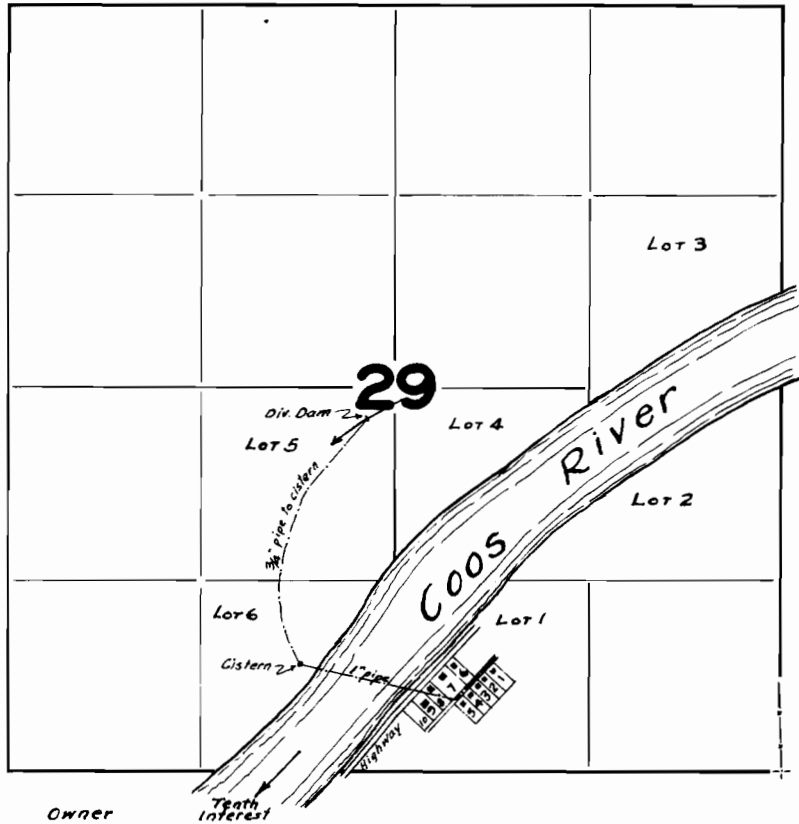

| Owner | Teath Interest |
|----------------------|----------------|
| 1.- Alf Stone | 1 |
| 2.- Mrs. Fred Stone | 1 |
| 3.- Torgney Finnel | 1 |
| 4.- Phil Borgman | 1 |
| 5.- Cal Hicks | 1 |
| 6.- Claire Heath | 1 |
| 7.- Charles Fox | 2 |
| 8.- John Hendrickson | 1 |
| 9.- Joe Kroensteiner | 1 |
| 10.- Irvin Watson | 0 |

FINAL PROOF SURVEY UNDER

Application No. 17276 Permit No. 12986

IN NAME OF

Irvin Watson

Surveyed Aug. 20, 1943, by Scott Gaderman