


T. 8 S., R. 3 W. W.M.

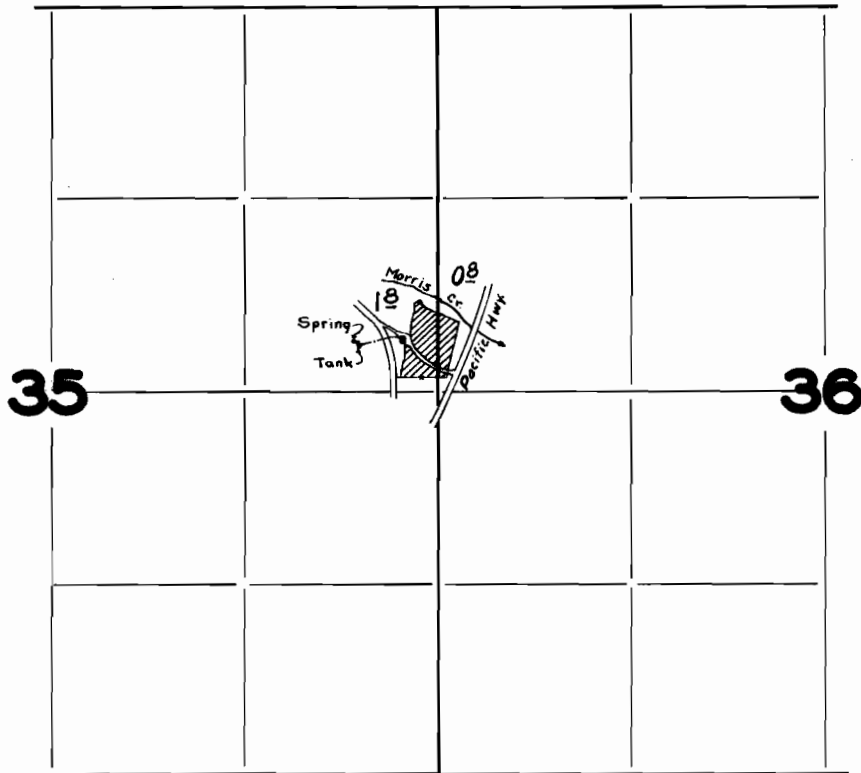

FINAL PROOF SURVEY
UNDER

Application No. 17053 Permit No. 13016

IN NAME OF

Max L. Alford

Surveyed July 13, 1942, by Geo. W. Spederman