


# T.16 S., R. 7 W. W.M.

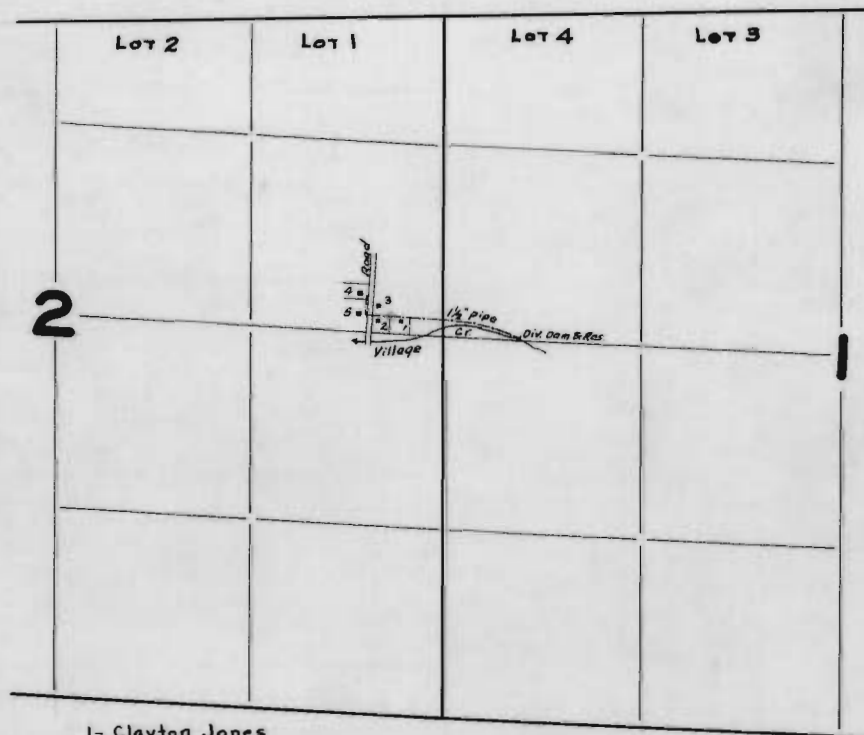

- 1- Clayton Jones
- 2- C. P. Laferty
- 3- Louis James
- 4- Allard James
- 5- Wm E. James

## FINAL PROOF SURVEY UNDER

Application No. 17378 Permit No. 13079

IN NAME OF

Clayton Jones, C. P. Laferty,  
Louis James, W. E. James & Allard James

Surveyed Aug 6, 1943, by Geo. W. Spaderman