


T. 15 S., R. 4 W. W.M.

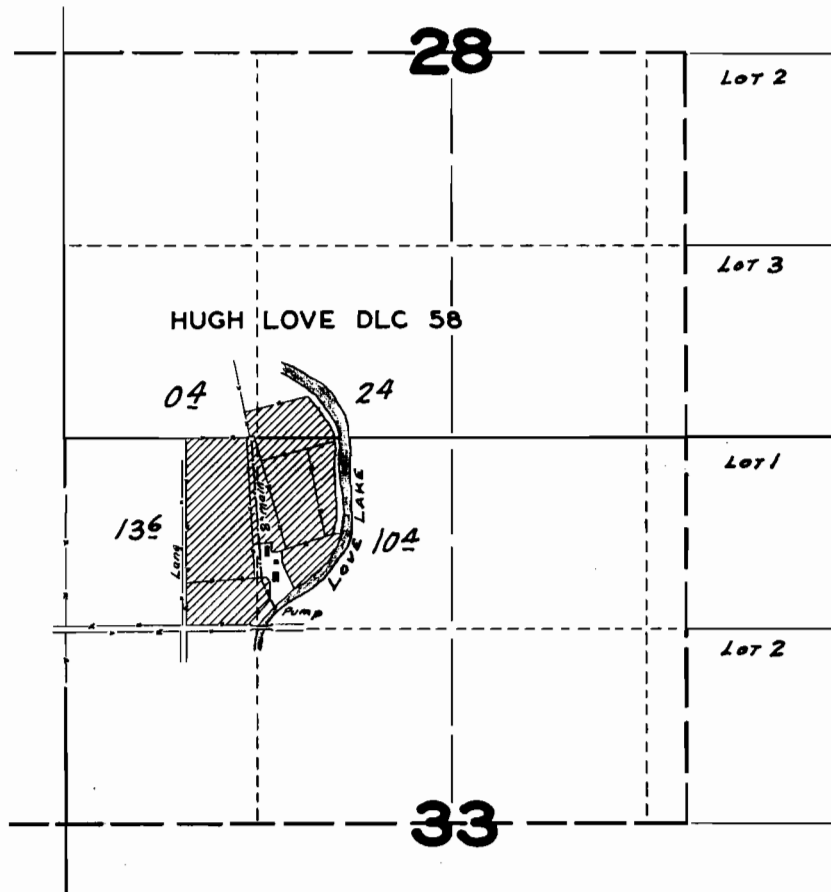

FINAL PROOF SURVEY
UNDER

Application No. 17408 Permit No. 13106

IN NAME OF

Folmer Bodtker

Surveyed Aug. 3, 1943, by Geo. W. Adelman