


T. 28 S., R. 14 W.W.M.

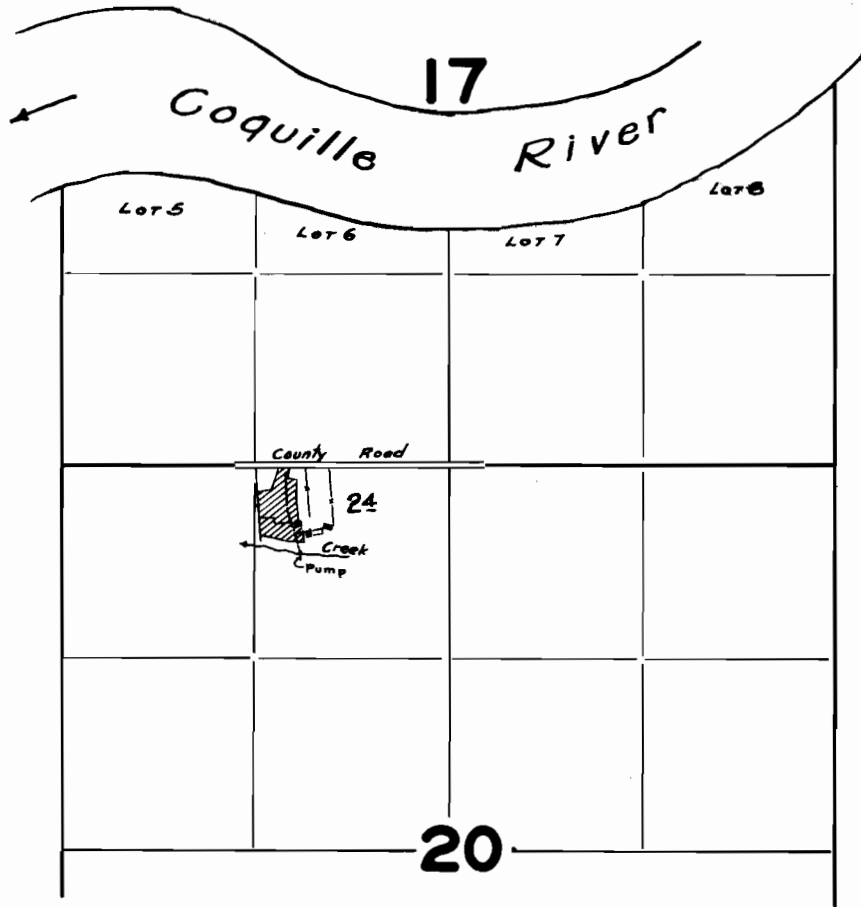

**FINAL PROOF SURVEY
UNDER**

Application No. 17421 Permit No. 13117

IN NAME OF

Ludwig & Maude Myrberg

Surveyed Aug 31 1943, by Geoff Naderman