


T. 29 S., R. 13 W. W.M.

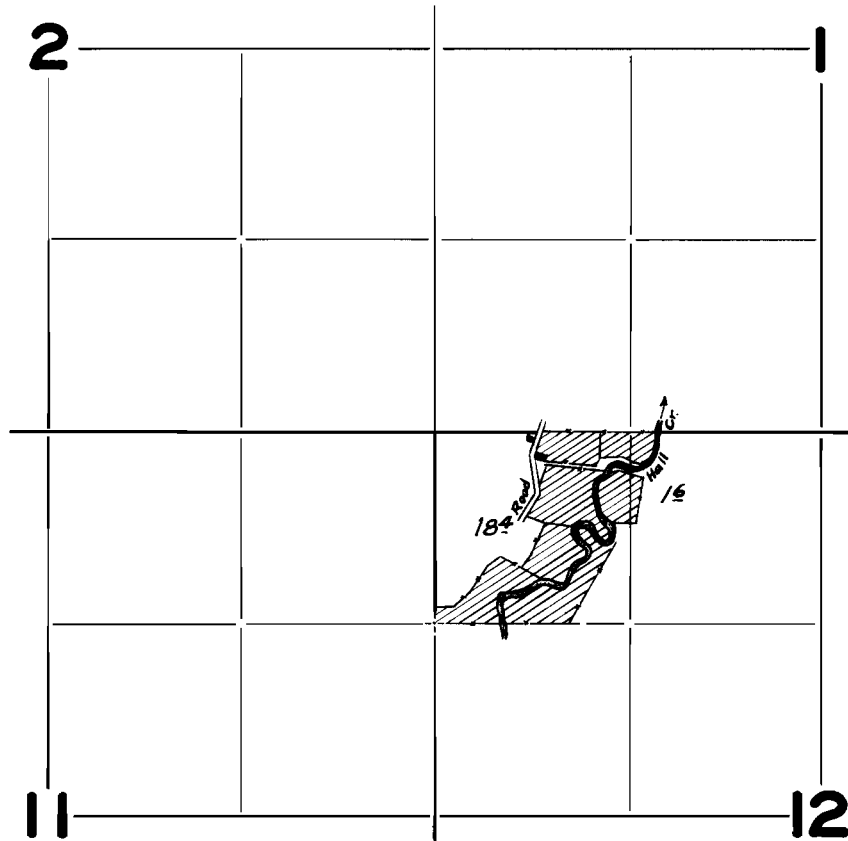

FINAL PROOF SURVEY
UNDER

Application No. 17442 Permit No. 13130

IN NAME OF

O. H. Aasen

Surveyed Aug. 28 1943, by Geo. Maderman