


T. 5 S., R. 1 W. W.M.

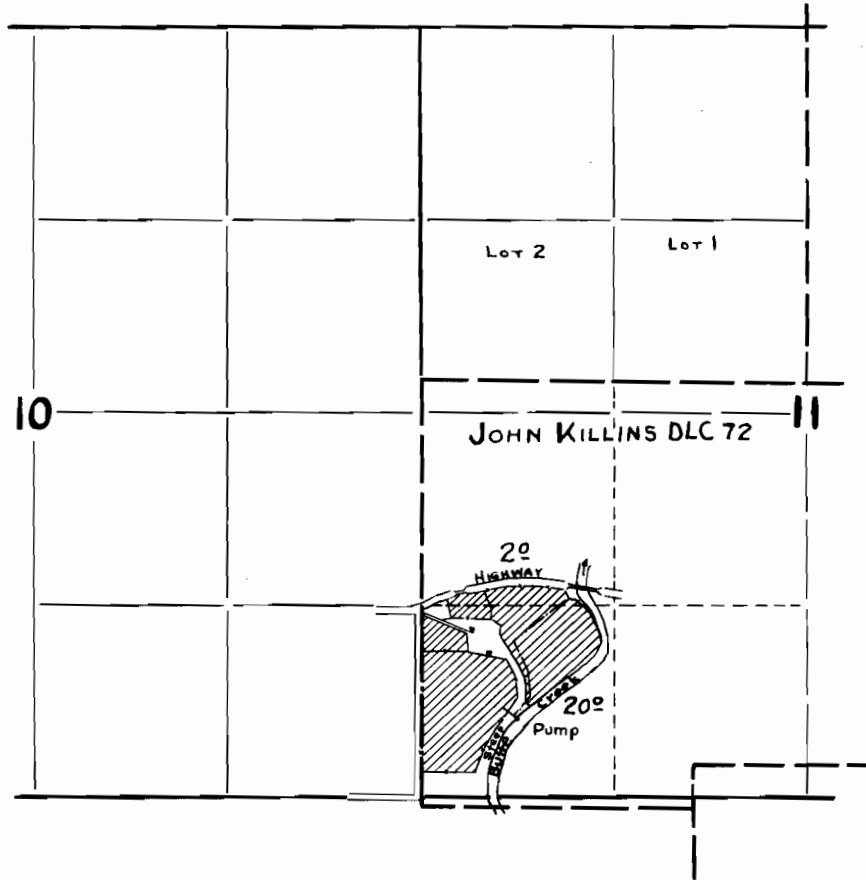

FINAL PROOF SURVEY UNDER

Application No. 17115 Permit No. 13136

IN NAME OF

Owen McNulty

Surveyed Sept. 22 1943, by *Geo. W. Haderman*