


T. 6 S., R. 1 E. W.M.

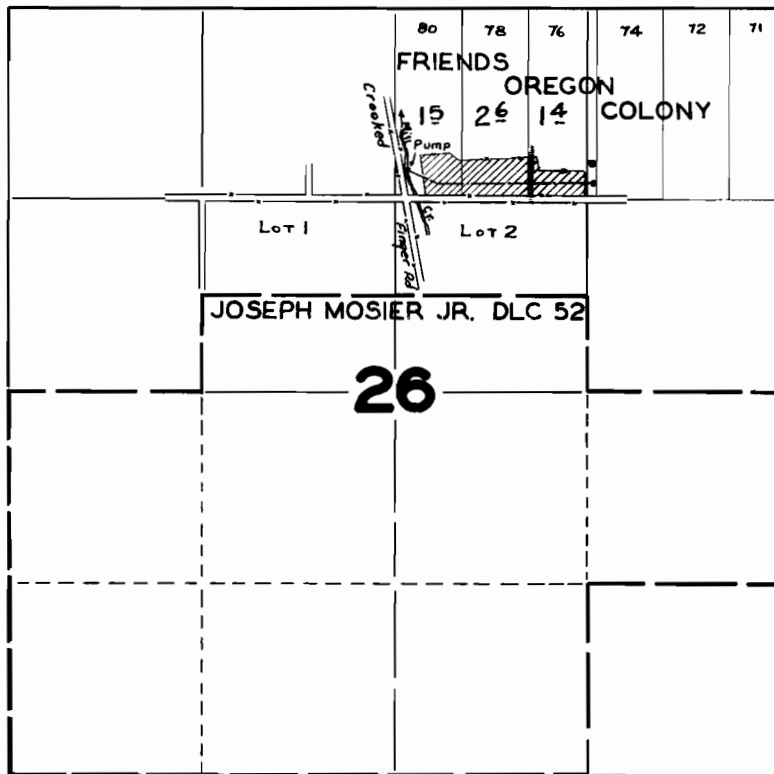

FINAL PROOF SURVEY UNDER

Application No. 17364 Permit No. 13142

IN NAME OF

L.W. Kellis

Surveyed Sept. 20 1943, by Geol. Mademan