


T. 29 S., R. 8 W. W.M.

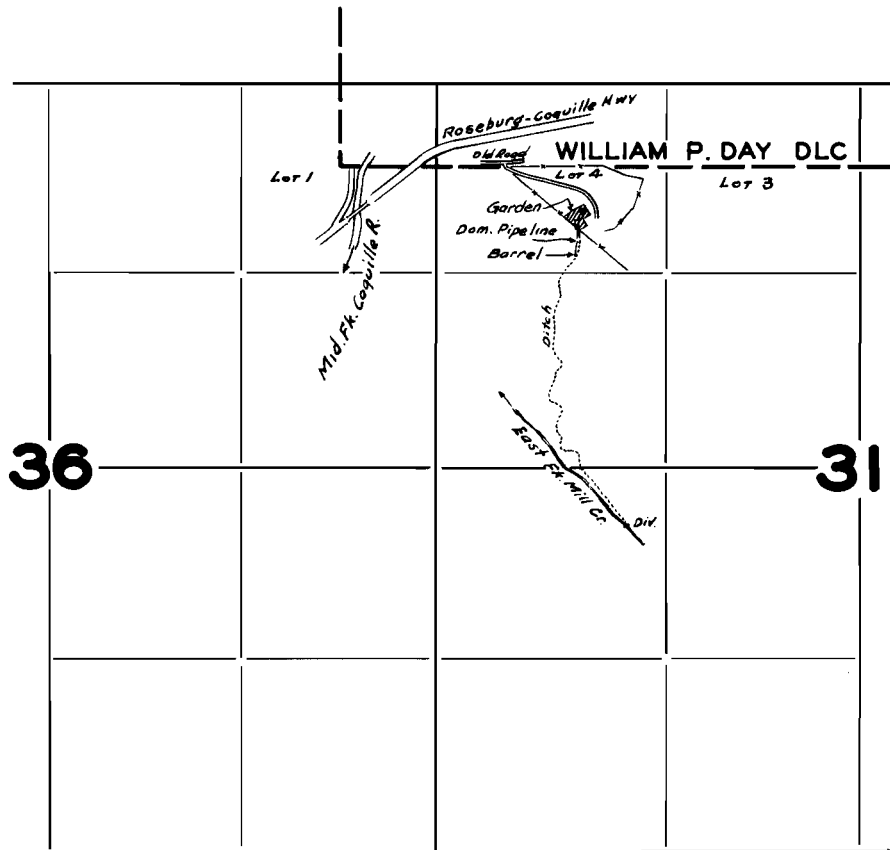

**FINAL PROOF SURVEY
UNDER**

Application No. 17391 Permit No. 13146

IN NAME OF

Floyd A. Stobie

Surveyed Sept. 4, 1943, by Geo. W. Aderman