


T. 24 S., R. 13 W. W.M.

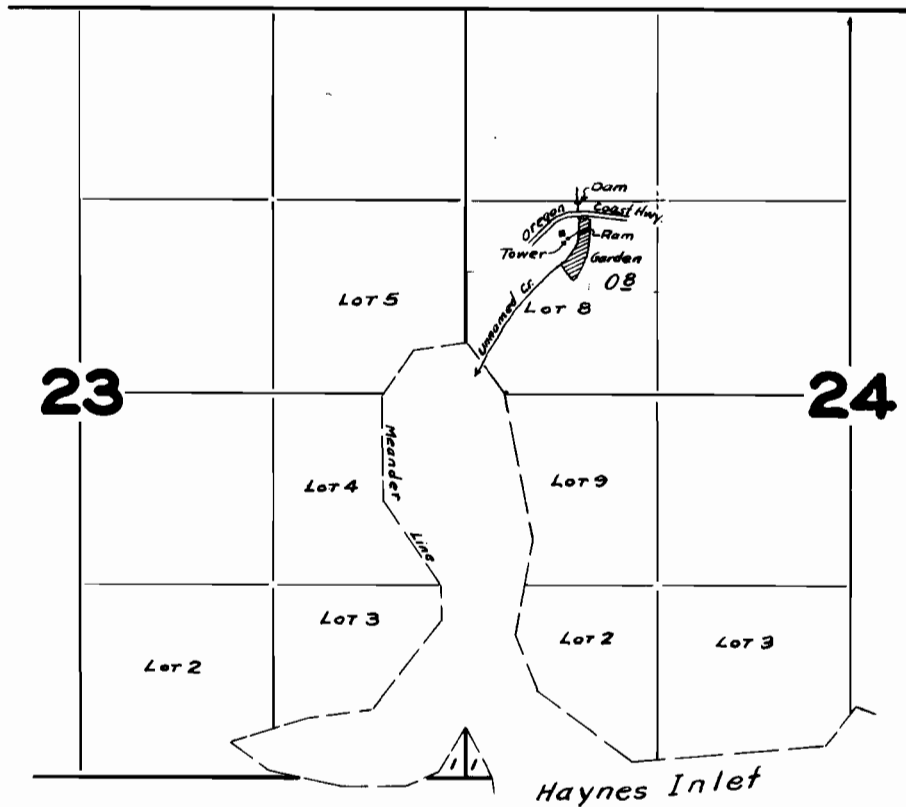

FINAL PROOF SURVEY
UNDER

Application No. 17556 Permit No. 13259

IN NAME OF

Florence H. Conner

Surveyed Aug. 17 1943, by Earl Mademan