


T. 24 S., R. 13 W. W.M.

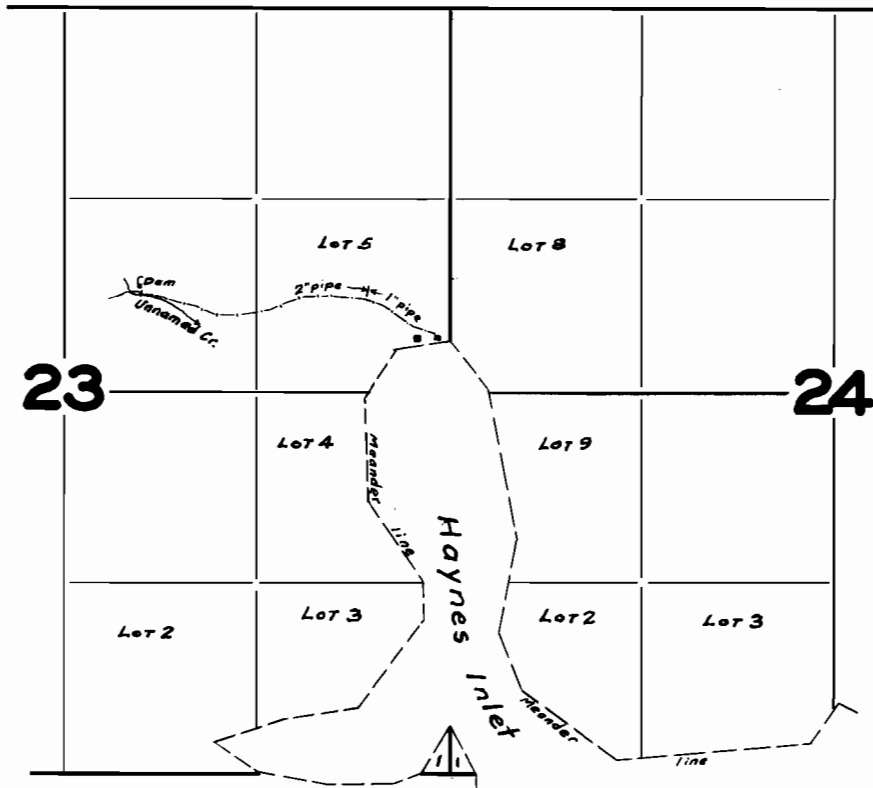

FINAL PROOF SURVEY
UNDER

Application No. 17587 Permit No. 13284

IN NAME OF

Charles V. Peterson

Surveyed Aug. 17 1943, by Geo. Maderman