


T. 20 S., R. 11 W. W.M..

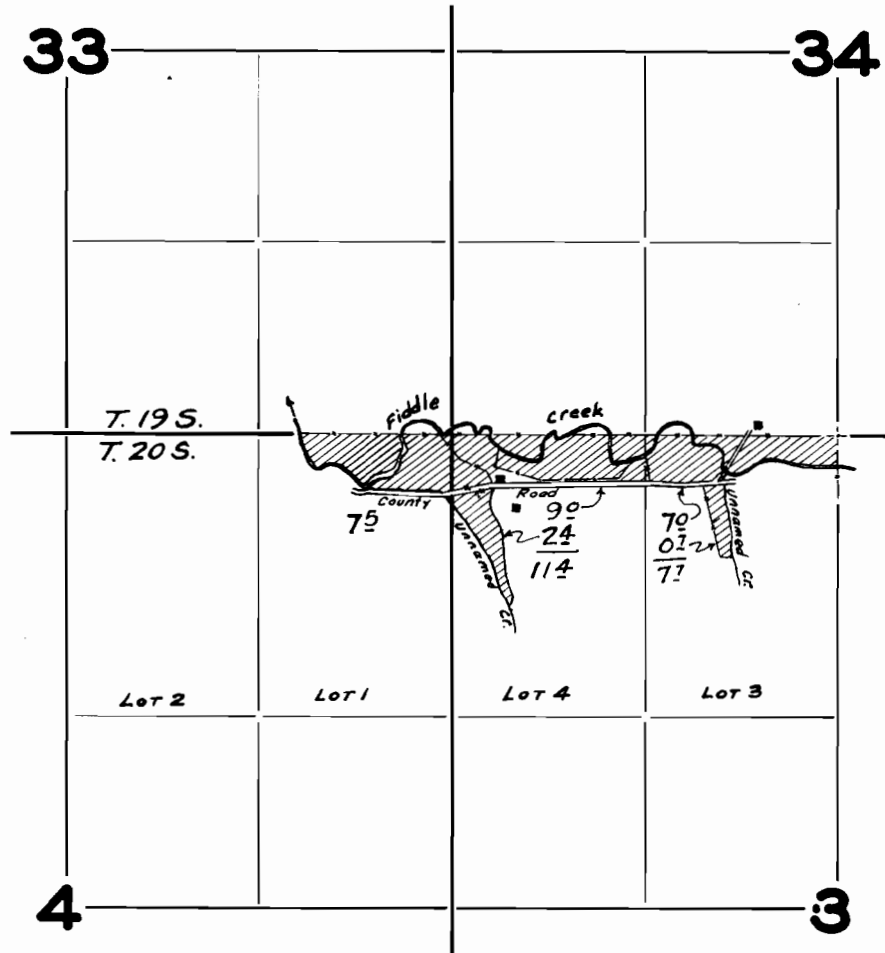

FINAL PROOF SURVEY
UNDER

Application No. 17607 Permit No. 13328

IN NAME OF

Ella May Moss

Surveyed Aug. 12 1943, by Geo. J. Naderman