


T. 22 S., R. 4 W. W.M.

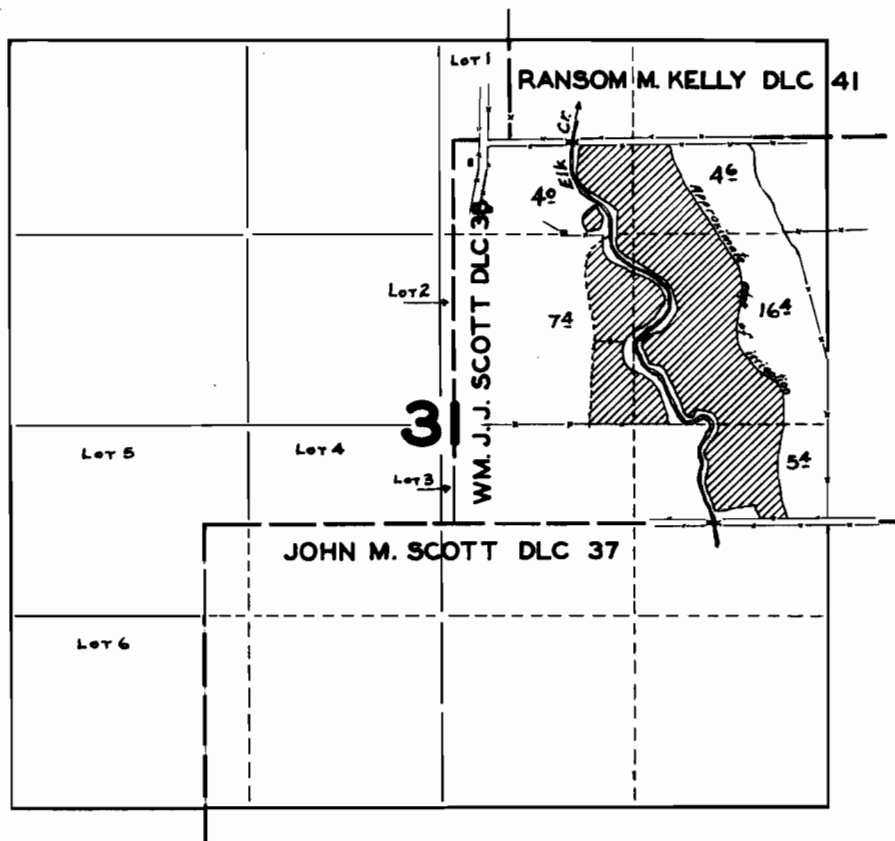

**FINAL PROOF SURVEY
UNDER**

Application No. 17814 Permit No. 13488

IN NAME OF

Gerald Johnson

Surveyed Sept. 14, 1943, by Geo. Maderman